

MISSISSIPPI DEPARTMENT OF NATURAL RESOURCES

Bureau of Land and Water Resources

Southport Mall

P.O. Box 10631

Jackson, Mississippi 39209

WATER WELL DRILLERS LOG

TOM GRIFFITH

PLUMBING & WELL SERVICE, INC.

Marion

Marion
E
2032

3-31 1983

date well completed

511 LAAYSON AVE.
COLUMBIA, MS 39202

county well located

LANDOWNER:	description of formations encountered	from	to
Fleet Farrow	Top soil	0'	1'
RH1	Gravel	1'	110'
Darboon, Ms.	Chalk	110'	115'
(mailing address)	Gravel	115'	160'
WELL LOCATION:			
sec. 4 T. 4 N. R. 12 E			
6 miles E of Darboon, Ms.			
(distance) (direction) (nearest town)			
WELL PURPOSE:			
Home			
(home, irrigation, municipal, industrial)			
WELL COMPLETION DATA:			
(1) diameter (inches) 4"			
(2) total depth (feet) 140'			
(3) static water level (feet) 120' below top of ground.			
(4) casing P.V.C. 140'			
(material) (depth)			
N/A if telescope see back.			
(5) screen 20' 140'			
(length) (depth to top)			
4" P.V.C.			
(size) (material)			
(6) pump 3/4 12			
(HP) (yield gpm)			
electric			
(type power)			
(7) electric log none			
(yes or no)			
N/A			
(organization running log)			
(8) how well bottom plugged BCW			
DRILLERS REMARKS:			


DEPT. OF NATURAL RESOURCES
BUREAU OF LAND & WATER RESOURCES

APR 20 1983

RECEIVED

If well telescopes please sketch and show depths.

GROUND LEVEL

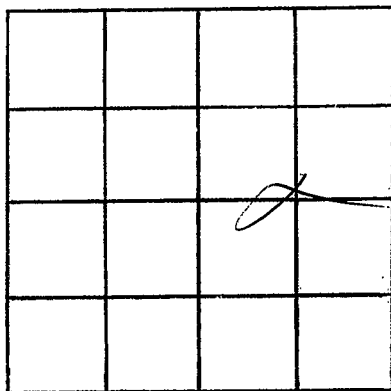

SECTION _____

Please indicate well location X.

ADDITIONAL INFORMATION

If more than one screen,
show locations of each on sketch.