

MISSISSIPPI DEPARTMENT OF NATURAL RESOURCES

Bureau of Land and Water Resources

Southport Mall

P.O. Box 10631

Jackson, Mississippi 39209

WATER WELL DRILLERS LOG

MARION
E
2033

2-14-1986 date well completed
 86 Tom Griffith Water Wells firm name
 Marion county well located

LANDOWNER: <u>Tommy Thompson</u>	description of formations encountered		from	to
<u>Rt. 1 Box 560</u>				
<u>Foxworth, MS 39483</u> (mailing address)	<u>top soil + clay</u>		<u>0</u>	<u>10</u>
	<u>SAND + PG.</u>		<u>10</u>	<u>135</u>
WELL LOCATION:				
sec. <u>17</u> T. <u>4</u> (N) R. <u>12</u> (E)				
<u>6</u> miles <u>W</u> of <u>Morgan town</u>				
(distance) (direction) (nearest town)				
WELL PURPOSE: <u>Heat Pump</u> (home, irrigation, municipal, industrial)				
WELL COMPLETION DATA:				
(1) diameter (inches) <u>4"</u>				
(2) total depth (feet) <u>135'</u>				
(3) static water level (feet) <u>70'</u> ^{below} _{above} top of ground.				
(4) casing <u>PVC</u> , <u>115'</u> (material) (depth)				
<u>NA</u> if telescope see back. (size)				
(5) screen <u>20'</u> , <u>115'</u> (length) (depth to top)				
<u>4"</u> , <u>PVC</u> (size) (material)				
(6) pump <u>3/4</u> , <u>10</u> (HP) (yield gpm)				
<u>elec.</u> (type power)				
(7) electric log <u>no</u> (yes or no)				
<u>BWV NA</u> (organization running log)				
(8) how well bottom plugged <u>BWV</u>				

RECEIVED


MAR 17 1986

Mississippi Department of Natural Resources
 Bureau of Land & Water Resources

DRILLERS REMARKS:

If well telescopes please sketch and show depths.

GROUND LEVEL

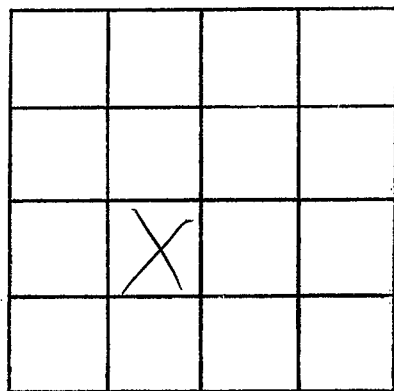

SECTION _____

Please indicate well location X.

ADDITIONAL INFORMATION

If more than one screen,
show locations of each on sketch.