

MISSISSIPPI DEPARTMENT OF NATURAL RESOURCES

Bureau of Land and Water Resources

COUNTY WELL LOCATED <i>Madison</i>	
WELL NUMBER <i>E</i>	CODED
<i>2034</i>	
DATE WELL COMPLETED <i>4-12-89</i>	

PERMIT NUMBER
NAME OF DRILLING FIRM <i>Hubbell Well Serv</i>

P.O. Box 10631
Jackson, Mississippi 39209
WATER WELL DRILLERS LOG

NAME & MAILING ADDRESS OF LANDOWNER <i>Bobby Donnan P.O. Foxworth, Miss.</i>			
WELL LOCATION: SEC <i>10</i> TOWNSHIP <i>4</i> RANGE <i>12</i> <i>S</i> <i>N</i> <i>E</i> <i>W</i>			
DISTANCE <i>5</i> Miles <i>W</i> of <i>Madison town</i>			
OTHER LANDMARK			
WELL PURPOSE: Home, Irrigation; Municipal; Industrial, Fish Pond, etc. <i>Home</i>			

PUMP DATA		
PUMP TYPE (Circle One): Submersible , Turbine, Jet, Flowing Well, Other (Describe)		
POWER TYPE (Circle One): <input checked="" type="radio"/> Electric, Tractor, Diesel, Gasoline, Butane, Other (Describe)		
Pump Capacity (GPM) <i>15</i>	No. of Stages <i>12</i>	Setting Depth <i>120</i> FT.
PUMP TEST		
Well yielded <i>15</i> GPM with a drawdown of <i>2</i> ft. after <i>2</i> hours of pumping		

WELL DATA		
Well Depth <i>170</i>	Casing Diameter (In.) <i>4</i>	Casing Length (Ft.) <i>160</i>
Type of Casing <i>PUC</i>	Hole Depth <i>170</i>	Depth to Static Water Level <i>91</i>
TYPE OF COMPLETION: (Circle One or More): <input checked="" type="checkbox"/> Gravel Packed, Underreamed, Telescoped, <input checked="" type="checkbox"/> Natural Development, Open Hole, Other		
Top of Lap Pipe or Reduction in Casing FEET <input type="checkbox"/> IF TELESCOPED OR MORE THAN ONE SCREEN: USE BACK PAGE		

LOG DATA	
TYPE OF LOG RUN (Circle One): Electric, Gamma Ray, Density, Sonic, <input checked="" type="checkbox"/> Neutron, Other (Describe)	
Name of Organization Running Log	

SCREEN DATA		
Diameter - Inches <i>4</i>	Length - Feet <i>10</i>	Slot Size - Inches <i>10/14</i>
Screen Type <i>PUC</i>		Depth to Bottom - Feet <i>170</i>


GEOLOGIC DATA (Office Use Only)			
Surface Elev.	Geologic Unit	Unit Thickness	Depth to Top
Subs. SWL	Date	Analysis	Aquifer Test
Driller's Remarks			

DESCRIPTION OF FORMATIONS ENCOUNTERED	FROM	TO
<i>Red Clay</i>	<i>0</i>	<i>20</i>
<i>Red sand</i>	<i>20</i>	<i>150</i>
<i>Coarse sand & gravel</i>	<i>150</i>	<i>170</i>

FORMATIONS (continued)	FROM	TO
RECEIVED		
JUN 7 1989		
Department of Natural Resources Bureau of Land & Water Resources		
IF MORE SPACE IS NEEDED, USE BACK		

If well telescopes please
sketch and show depths.

GROUND LEVEL

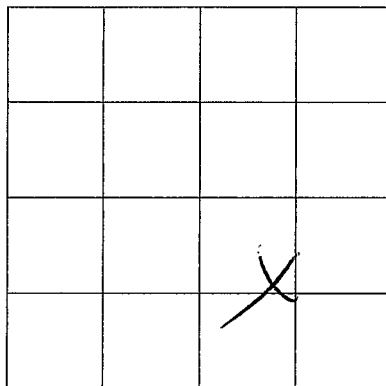

SECTION 10

Please indicate well location X.

ADDITIONAL INFORMATION

If more than one screen,
show location of each on sketch.