

MISSISSIPPI DEPARTMENT OF ENVIRONMENTAL QUALITY

Office of Land and Water Resources

P. O. Box 10631
Jackson, MS 39289-0631
WATER WELL DRILLERS LOG

COUNTY WELL LOCATED MARION	
WELL NUMBER # 2 W	CODED
E 2042	
DATE WELL COMPLETED Feb 16 - 94	

PERMIT NUMBER
NAME OF DRILLING FIRM FitzGERALD Well Serv

NAME & MAILING ADDRESS OF LANDOWNER WALTER LAUIGNE RR. Foxworth ms
--

PUMP DATA

PUMP TYPE (Circle One): <input checked="" type="checkbox"/> Submersible, Turbine, Jet, Flowing Well, Other (Describe) _____
POWER TYPE (Circle One): <input checked="" type="checkbox"/> Electric, Tractor, Diesel, Gasoline, Butane, Other (Describe) _____ H/P <u>1</u>

WELL LOCATION: SEC <u>32</u> TOWNSHIP <u>4</u> RANGE <u>12</u>	N S E W
--	------------------

Pump Capacity (GPM) <u>20</u>	No. of Stages <u>10</u>	Setting Depth <u>90</u> FT.
----------------------------------	----------------------------	--------------------------------

DISTANCE <u>2</u> Miles DIRECTION <u>E</u> of NEAREST TOWN <u>DARBON</u>
OTHER LANDMARK

PUMP TEST
Well yielded <u>45</u> GPM with a drawdown of <u>2</u> ft. after <u>1</u> hours of pumping

WELL PURPOSE: Home, Irrigation, Municipal, Industrial, Fish Pond, etc. Point of House

WELL DATA

Well Depth <u>120</u>	Casing Diameter (In.) <u>4</u>	Casing Length (Ft.) <u>110</u>
Type of Casing <u>NUC</u>	Hole Depth <u>120</u>	Depth to Static Water Level <u>53</u>

LOG DATA

TYPE OF LOG RUN (Circle One): Electric, Gamma Ray, Density, Sonic, Neutron, Other (Describe) _____	<input checked="" type="checkbox"/> No Log Run
Name of Organization Running Log	

TYPE OF COMPLETION: (Circle One or More): <input checked="" type="checkbox"/> Gravel Packed, Underreamed, Telescoped, Natural Development, Open Hole, Other (Describe) _____

GEOLOGIC DATA (Office Use Only)

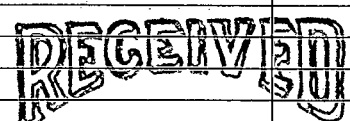
Surface Elev.	Geologic Unit	Unit Thickness	Depth to Top
Subs. SWL	Date	Analysis	Aquifer Test

WELL GROUTED TO A DEPTH OF <u>10</u> FEET Type Grout (circle one): Cement, Bentonite, or Mix <input checked="" type="checkbox"/>

Driller's Remarks

SCREEN DATA

Diameter - Inches <u>4</u>	Length - Feet <u>10</u>	Slot Size - Inches <u>.014</u>
Screen Type <u>NUC</u>	Depth to Bottom - Feet <u>120</u>	

DESCRIPTION OF FORMATIONS ENCOUNTERED	FROM	TO	FORMATIONS (Continued)	FROM	TO
Red Clay	0	20	 MAR 01 1994 Dept. of Environmental Quality Office of Land & Water Resources		
Red Sand	20	104			
COURSE SAND & GRAVEL	104	120			

IF MORE SPACE IS NEEDED, USE BACK

