

MISSISSIPPI DEPARTMENT OF ENVIRONMENTAL QUALITY

Office of Land and Water Resources

P. O. Box 10631
Jackson, MS 39289-0631
WATER WELL DRILLERS LOG

COUNTY WELL LOCATED	
MAR:04	
WELL NUMBER	CODED
E 2045	
DATE WELL COMPLETED	
Aug 8-94	

PERMIT NUMBER
NAME OF DRILLING FIRM
FitzGerald Well Service

NAME & MAILING ADDRESS OF LANDOWNER			
Steve Rowley			
P.O. Kokomo, MS			
WELL LOCATION	SEC	TOWNSHIP	RANGE
	29	4 N	12 E
		S	W
DISTANCE	DIRECTION	NEAREST TOWN	
2 Miles	E	DARBON	
OTHER LANDMARK			
WELL PURPOSE: Home, Irrigation, Municipal, Industrial, Fish Pond, etc.			
Poul'RAY House			

PUMP DATA			
PUMP TYPE (Circle One):			
Submersible	Turbine	Jet	Flowing Well
Other (Describe)			
POWER TYPE (Circle One):			
Electric	Tractor	Diesel	Gasoline
Other (Describe)			
Pump Capacity (GPM)	No. of Stages	Setting Depth	
20	10	125 FT.	
PUMP TEST			
Well yielded 35 GPM with			
a drawdown of 2 ft.			
after 2 hours of pumping			

WELL DATA		
Well Depth	Casing Diameter (In.)	Casing Length (Ft.)
175	4	165
Type of Casing	Hole Depth	Depth to Static Water Level
NSC	175	81

LOG DATA	
TYPE OF LOG RUN (Circle One):	
Electric	No Log Run
Gamma Ray	Density
Sonic	Neutron
Other (Describe)	
Name of Organization Running Log	


TYPE OF COMPLETION: (Circle One or More):	
Gravel Packed	Underreamed
Natural Development	Telescoped
Open Hole	Other
(Describe)	
WELL GROUTED TO A DEPTH OF 10 FEET	
Type Grout (circle one): Cement, Bentonite, or Mix	

GEOLOGIC DATA (Office Use Only)			
Surface Elev.	Geologic Unit	Unit Thickness	Depth to Top
Subs. SWL	Date	Analysis	Aquifer Test

SCREEN DATA		
Diameter - Inches	Length - Feet	Slot Size - Inches
4	10	10/32
Screen Type	Depth to Bottom - Feet	
NSC	175	


Driller's Remarks	
Top of Lap Pipe or Reduction in Casing	
FEET	IF TELESCOPED OR MORE THAN ONE SCREEN: USE BACK PAGE

DESCRIPTION OF FORMATIONS ENCOUNTERED	FROM	TO
Red Clay	0	20
Red Sand	20	161
COURSE SAND & GRAVEL	161	175

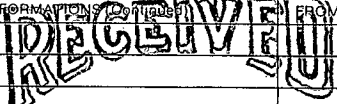FORMATIONS ENCOUNTERED	FROM	TO
		
OCT 14 1994		
Dept. of Environmental Quality Office of Land & Water Resources		
IF MORE SPACE IS NEEDED, USE BACK		

If well telescopes please sketch and show depths.

GROUND LEVEL

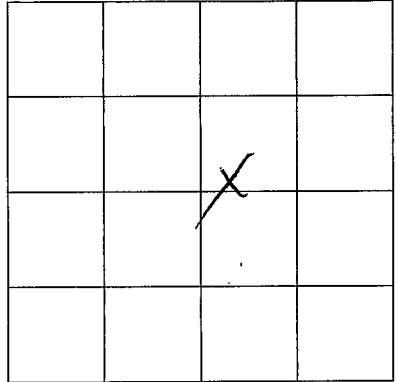

SECTION 29

Please indicate well location X.

ADDITIONAL INFORMATION

If more than one screen,
show location of each on sketch.