

MISSISSIPPI DEPARTMENT OF ENVIRONMENTAL QUALITY

Office of Land and Water Resources

P. O. Box 10631
Jackson, MS 39289-0631
WATER WELL DRILLERS LOG

COUNTY WELL LOCATED <i>MAA:OH</i>	
WELL NUMBER <i>E 2046</i>	CODED
DATE WELL COMPLETED <i>Aug 9-94</i>	

PERMIT NUMBER
NAME OF DRILLING FIRM <i>FITZGERALD well serv</i>

NAME & MAILING ADDRESS OF LANDOWNER <i>Steve Rowley</i>			
<i>RR. Kiborno</i>			
WELL LOCATION: SEC	TOWNSHIP	RANGE	
<i>29</i>	<i>4</i>	<i>N</i>	<i>E</i>
DISTANCE		DIRECTION	NEAREST TOWN
<i>2</i> Miles		<i>E</i>	<i>Andover</i>
OTHER LANDMARK			
WELL PURPOSE: Home, Irrigation, Municipal, Industrial, Fish Pond, etc. <i>oultry house</i>			

PUMP DATA		
PUMP TYPE (Circle One): Submersible , Turbine, Jet, Flowing Well, Other (Describe) _____		
POWER TYPE (Circle One): Electric , Tractor, Diesel, Gasoline, Butane, Other (Describe) _____ H/P <i>1</i>		
Pump Capacity (GPM) <i>20</i>	No. of Stages <i>10</i>	Setting Depth <i>125</i> FT.
PUMP TEST		
Well yielded <i>40</i> GPM with a drawdown of <i>2</i> ft. after <i>2</i> hours of pumping		

WELL DATA		
Well Depth <i>175'</i>	Casing Diameter (In.) <i>4</i>	Casing Length (Ft.) <i>165</i>
Type of Casing <i>PVC</i>	Hole Depth <i>175</i>	Depth to Static Water Level <i>81</i>
TYPE OF COMPLETION: (Circle One or More): Gravel Packed , Underreamed, Telescoped, Natural Development, Open-Hole, Other (Describe) _____		

LOG DATA	
TYPE OF LOG RUN (Circle One): No Log Run , Electric, Gamma Ray, Density, Sonic, Neutron, Other (Describe) _____	
Name of Organization Running Log	

WELL GROUTED TO A DEPTH OF <i>10</i> FEET Type Grout (circle one): Cement, Bentonite, or Mix
--

GEOLOGIC DATA (Office Use Only)			
Surface Elev.	Geologic Unit	Unit Thickness	Depth to Top
Subs. SWL	Date	Analysis	Aquifer Test

SCREEN DATA		
Diameter - Inches <i>4</i>	Length - Feet <i>10</i>	Slot Size - Inches <i>10/2</i>
Screen Type <i>PVC</i>	Depth to Bottom - Feet <i>175'</i>	


Driller's Remarks
Top of Lap Pipe or Reduction in Casing
FEET
IF TELESCOPED OR MORE THAN ONE SCREEN: USE BACK PAGE

DESCRIPTION OF FORMATIONS ENCOUNTERED	FROM	TO
<i>Red Clay</i>	<i>0</i>	<i>20</i>
<i>Red Sand</i>	<i>20</i>	<i>159</i>
<i>Coarse Sand & gravel</i>	<i>159</i>	<i>175</i>

FORMATIONS (Continued)	FROM	TO
RECEIVED		
OCT 14 1994		
Dept. of Environmental Quality Office of Land & Water Resources		
IF MORE SPACE IS NEEDED, USE BACK		

If well telescopes please sketch and show depths.

GROUND LEVEL

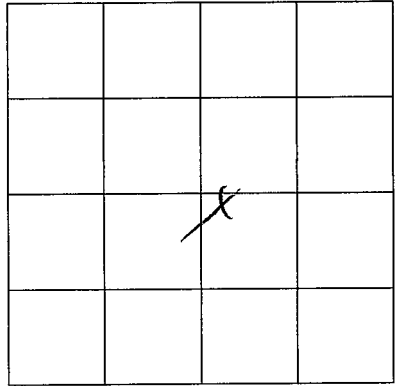

SECTION 29

Please indicate well location X.

ADDITIONAL INFORMATION

If more than one screen,
show location of each on sketch.