

Marion
 E 2548
 Jan. 1976

MISSISSIPPI
 BOARD OF WATER COMMISSIONERS
 416 North State Street
 Jackson, Mississippi 39201

WATER WELL DRILLERS LOG

JAN. 1976 ¹³¹ E. B. SHERRARD MARION
 date well completed firm name county well located

LANDOWNER:

Mrs. CURTIS LEE
 FOXWORTH, MISS.
 (mailing address)

description of formations
 encountered

from to

LOOSE RED SANDY
 CLAY 0 80'
 GRAVEL STRIERS 80 130'
 SAND & GRAVEL 130 185'

WELL LOCATION:

sec 26 T 4 N R 12 E
 6 miles NW of FOXWORTH
 (distance) (direction) (nearest town)

WELL PURPOSE:

(home) Irrigation, municipal, industrial

WELL COMPLETION DATA:

- (1) diameter (inches) 2"
- (2) total depth (feet) 185'
- (3) static water level (feet) 110' ^{below} above top of ground.
- (4) casing pl. 180'
 (material) (depth)
 2" If telescope see back.
 (size)
- (5) screen 5'
 (length) (depth to top)
 2" pl.
 (size) (material)
- (6) pump 1 1/2 7
 (HP) (yield gpm)
 E
 (type power)
- (7) electric log (yes or no) (no)
- (organization running log)
- (8) how well bottom plugged BWV

DRILLERS REMARKS:


RECEIVED

OCT 18 1976

MISS. BD. OF WATER COMM

If well telescopes please sketch and show depths.

GROUND LEVEL

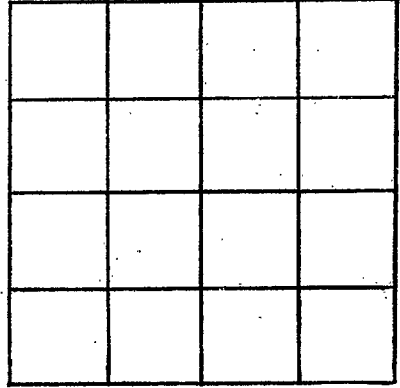

SECTION _____

Please indicate well location X.

ADDITIONAL INFORMATION

If more than one screen,
show locations of each on sketch.