

MISSISSIPPI DEPARTMENT OF ENVIRONMENTAL QUALITY

Office of Land and Water Resources

P. O. Box 10631
Jackson, MS 39289-0631
WATER WELL DRILLERS LOG

COUNTY WELL LOCATED Madison	
WELL NUMBER E-2050	CODED
DATE WELL COMPLETED 6-14-99	

PERMIT NUMBER 0-621
NAME OF DRILLING FIRM Daniel Boone
Tylertown, MS

NAME & MAILING ADDRESS OF LANDOWNER David Bozeman			
652 Pine Ground Church Rd			
Foxworth, MS			
WELL LOCATION ... SEC	TOWNSHIP	RANGE	
20	4	12	
DISTANCE		DIRECTION	NEAREST TOWN
9 Miles		NW	Foxworth
OTHER LANDMARK Darbin Community			
WELL PURPOSE: Home, Irrigation, Municipal, Industrial, Fish Pond, etc.			

PUMP DATA		
PUMP TYPE (Circle One): <input checked="" type="radio"/> Submersible, Turbine, Jet, Flowing Well, Other (Describe) _____		
POWER TYPE (Circle One): <input checked="" type="radio"/> Electric, Tractor, Diesel, Gasoline, Butane, Other (Describe) _____ H/P 2		
Pump Capacity (GPM) 25	No. of Stages	Setting Depth 170 FT.
PUMP TEST		
Well yielded 35 GPM with a drawdown of 55 ft. after 12 hours of pumping		

WELL DATA		
Well Depth 185	Casing Diameter (In.) 4"	Casing Length (Ft.) 155'
Type of Casing PVC Sch 40	Hoie Depth 188	Depth to Static Water Level 85'
TYPE OF COMPLETION: (Circle One or More): <input checked="" type="radio"/> Gravel Packed, Underreamed, Telescoped, Natural Development, Open Hoie, Other (Describe) _____		
WELL GROUTED TO A DEPTH OF 10 FEET Type Grout (circle one): <input checked="" type="radio"/> Cement, Bentonite, or Mix		

LOG DATA	
TYPE OF LOG RUN (Circle One): Electric, Gamma-Ray, Density, Sonic, Neutron, Other (Describe) _____ <input checked="" type="radio"/> No Log Run	
Name of Organization Running Log: _____	


SCREEN DATA		
Diameter - Inches 4	Length - Feet 30'	Slot Size - Inches .004
Screen Type PVC Sch. 40		Depth to Bottom - Feet 3'

GEOLOGIC DATA (Office Use Only)			
Surface Elev.	Geologic Unit	Unit Thickness	Depth to Top
Subs. SWL	Date	Analysis	Aquifer Test
Driller's Remarks			
Top of Lap Pipe or Reduction in Casing			
FEET		IF TELESCOPED OR MORE THAN ONE SCREEN: USE BACK PAGE	

DESCRIPTION OF FORMATIONS ENCOUNTERED	FROM	TO	FORMATIONS (Continued)	FROM	TO
Clay	0	12	DISCOVERED	10	
Powder Sand	12	30			
Sand + Large Gravel	30	185			
Clay	185	188			
			AUG 19 1999		
Dept of Environmental Quality Office of Land & Water Resources					
IF MORE SPACE IS NEEDED, USE BACK					

If well telescopes please sketch and show depths.

GROUND LEVEL

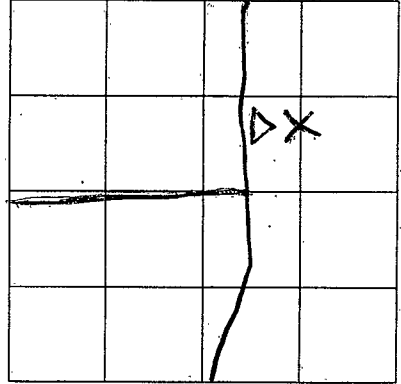

SECTION _____

Please indicate well location X.

ADDITIONAL INFORMATION

Well is at some
chicken houses

RECEIVED
MAY 1 1980

WATER RESOURCES DIVISION
U.S. GEOLOGICAL SURVEY

If more than one screen,
show location of each on sketch.