

MISSISSIPPI DEPARTMENT OF ENVIRONMENTAL QUALITY

Office of Land and Water Resources

P. O. Box 10631
Jackson, MS 39289-0631
WATER WELL DRILLERS LOG

COUNTY WELL LOCATED Marion	
WELL NUMBER E 2052	CODED
DATE WELL COMPLETED 6-27-99	

PERMIT NUMBER 0-621
NAME OF DRILLING FIRM Daniel Boone
Tylertown MS

NAME & MAILING ADDRESS OF LANDOWNER Joe Bracey			
308 Pine Grove Church Rd			
Hokoma MS 39043			
WELL LOCATION	SEC	TOWNSHIP	RANGE
	20	4	12
		S	W
DISTANCE	DIRECTION	NEAREST TOWN	
9 Miles	NW	of Foxworth	
OTHER LANDMARK Parbin Community			
WELL PURPOSE: Home, Irrigation, Municipal, Industrial, Fish Pond, etc.			

PUMP DATA			
PUMP TYPE (Circle One): Submersible Turbine, Jet, Flowing Well, Other (Describe) _____			
POWER TYPE (Circle One): Electric Tractor, Diesel, Gasoline, Butane, Other (Describe) _____ H/P 2			
Pump Capacity (GPM) 25	No. of Stages	Setting Depth 130 FT.	
PUMP TEST			
Well yielded 35 GPM with a drawdown of 40 ft. after 25 hours of pumping			

WELL DATA		
Well Depth 228	Casing Diameter (In.) 4"	Casing Length (Ft.) 198
Type of Casing PVC	Hole Depth 230	Depth to Static Water Level 60
TYPE OF COMPLETION: (Circle One or More): Gravel Packed , Underreamed, Telescoped, Natural Development, Open Hole, Other (Describe) _____		
WELL GROUTED TO A DEPTH OF 9 FEET Type Grout (circle one) Cement , Bentonite, or Mix		

LOG DATA	
TYPE OF LOG RUN (Circle One): No Log Run Electric, Gamma Ray, Density, Sonic, Neutron, Other (Describe) _____	
Name of Organization Running Log: _____	

SCREEN DATA		
Diameter - Inches 4"	Length - Feet 30'	Slot Size - Inches .008
Screen Type PVC Sch 40	Depth to Bottom - Feet 2'	


GEOLOGIC DATA (Office Use Only)			
Surface Elev.	Geologic Unit	Unit Thickness	Depth to Top
Subs. SWL	Date	Analysis	Aquifer Test
Driller's Remarks			
Top of Lap Pipe or Reduction in Casing			
FEET		IF TELESCOPED OR MORE THAN ONE SCREEN: USE BACK PAGE	

DESCRIPTION OF FORMATIONS ENCOUNTERED	FROM	TO	FORMATIONS (Continued)	FROM	TO
Clay	0	19	RECEIVED AUG 19 1999 Dept of Environmental Quality Office of Land & Water Resources		
Sand & Gravel	19	60			
Clay	60	130			
Sand & Pea Gravel	130	228			
Clay	228	230			

IF MORE SPACE IS NEEDED: USE BACK

If well telescopes please sketch and show depths.

GROUND LEVEL

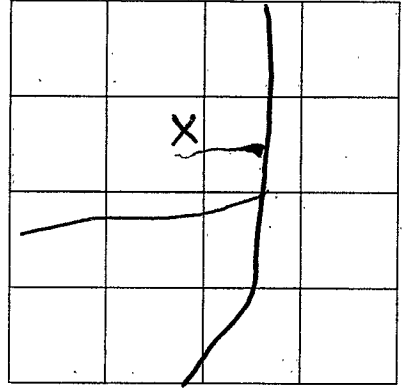

SECTION 20

Please indicate well location X.

ADDITIONAL INFORMATION

*This is the second
of two wells at same
location*

*Well for chicken
houses.*

RECEIVED

NOV 19 1964

U.S. DEPARTMENT OF AGRICULTURE
NATIONAL BUREAU OF SOIL CONSERVATION

If more than one screen,
show location of each on sketch.