

Marion (?)
 F. I.
 6-64

MISSISSIPPI
 BOARD OF WATER COMMISSIONERS **CODED**
 416 North State Street
 Jackson, Mississippi 39201

WATER WELL DRILLERS LOG

June 1964 M/R RIVER DRILLING SERVICE, INC. MARION
 date well completed firm name county well located

LANDOWNER: MORGAN TOWN
Water Assn
Morgan Town, Miss
 (mailing address)

description of formations encountered	from	to
	<u>Top Soil</u>	<u>0</u>
<u>Clay</u>	<u>2</u>	<u>12</u>
<u>Sand</u>	<u>12</u>	<u>85</u>
<u>Clay</u>	<u>85</u>	<u>92</u>
<u>Sand</u>	<u>92</u>	<u>140</u>

WELL LOCATION:
 sec. 17 T 4 S R 19 E
 (distance) miles (direction) of (nearest town)

WELL PURPOSE: MUNICIPAL
 (home, irrigation, municipal, industrial)

CODED


- WELL COMPLETION DATA:
- diameter (inches) 4 5/8"
 - total depth (feet) 140'
 - static water level (feet) 20' below above top of ground.
 - casing Steel, 100'
 (material) (depth)
450' if telescope see back.
 (size)
 - screen 40', 100'
 (length) (depth to top)
2 1/2", Stainless
 (size) (material)
 - pump 7 1/2 50 GPM
 (HP) (yield gpm)
Fluo
 (type power)
 - electric log No
 (yes or no)
 (organization running log)
 - how well bottom plugged Block
wash

APR 15 1964

DRILLERS REMARKS:

If well telescopes please sketch and show depths.

GROUND LEVEL

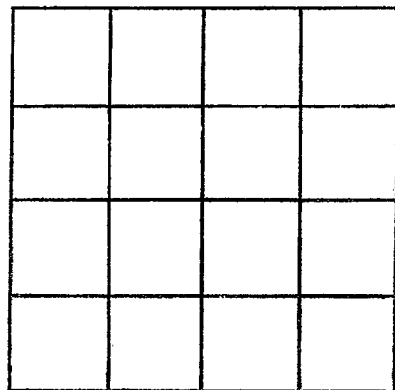

SECTION _____

Please indicate well location X.

ADDITIONAL INFORMATION

If more than one screen,
show locations of each on sketch.