

Marion
74
1-68

MISSISSIPPI
BOARD OF WATER COMMISSIONERS CODED
416 North State Street
Jackson, Mississippi 39201

WATER WELL DRILLERS LOG

1-23-68 19 Edward Water Well Marion
date well completed firm name county well located

LANDOWNER Balentine J. Joffe
Forworth Rd Miss -

description of formations encountered	from	to
Top soil	0	10
Red sand	10	63
Gravel	63	75
Sand	75	90
Gravel	90	112
Fine sand	112	131
Red chalk	131	145
Gravel	145	205

(mailing address)

WELL LOCATION:
sec. 13 T 4 N ✓ R 19 E ✓
S W
5 miles W Mariontown
(distance) (direction) (nearest town)

WELL PURPOSE: home
(home, irrigation, municipal, industrial)

WELL COMPLETION DATA:

(1) diameter (inches) 4 7/8

(2) total depth (feet) 201

(3) static water level (feet) 160 below above top of ground.

(4) casing plastic 154
(material) (depth)
4 1/2 if telescope see back.
(size)

(5) screen 6' 154
(length) (depth to top)
4 plastic Sch 40
(size) (material)


(6) pump Spec →
(HP) (yield gpm)
(type power)

(7) electric log NO
(yes or no)

(organization running log)

(8) how well bottom plugged Weld Plug


CODED
Heavy gravel

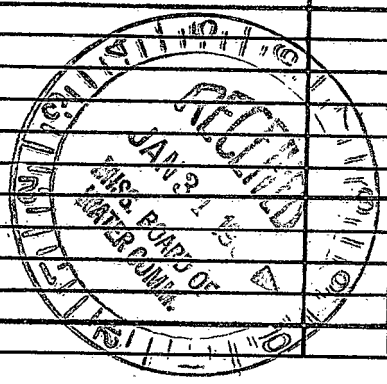

DRILLERS REMARKS:

If well telescopes please sketch and show depths.

GROUND LEVEL

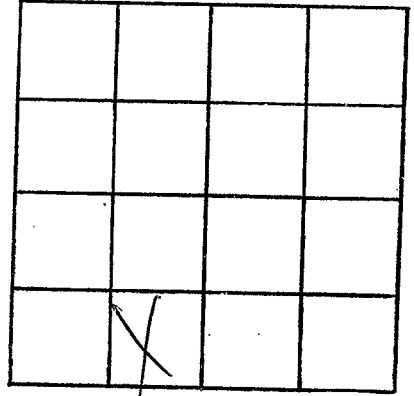

SECTION 13

Please indicate well location X.

ADDITIONAL INFORMATION

If more than one screen,
show locations of each on sketch.