

MARION

MISSISSIPPI BOARD OF WATER COMMISSIONERS

F 5

4-22-66

WATER WELL DRILLERS LOG

CODED

Date: 4-22, 1966, Driller: E.B. SHERBARD County Marion
(Name)

(1) Owner of Land: Willoughby
(Name)
Rt. 4 - Columbia
(Address)

(2) Location: 1/4, 1/4, Sec. 4 T⁴R¹⁹
2 1/2 miles SW, of Goss
(distance) (direction) (Nearest Town)

(3) Topography: (Hilly) (Flat) (Level)

(4) Purpose of Well: DOMESTIC
(Domestic Irrigation
Municipal, Industrial, Other)

Description & Color of Materials Sand, Clay, Red Clay, Shell, etc.	Thick- ness Feet	Depth Feet
<u>GRAY CLAY</u>	<u>14</u>	
<u>SAND</u>	<u>23</u>	
<u>BLUE CLAY</u>	<u>54</u>	
<u>WHITE COARSE SAND & GRAVEL</u>	<u>67</u>	
<u>CODED</u>		

Information upon completion of well:

(1) Diameter 2 inches.

(2) Total Depth 67 feet.

(3) Water Level 16 feet below top of ground.

(4) Cased to 67', Size 2"


(5) Screen: Size 2", Length 3'

(6) Were any formations sealed against pollution?
no

If YES depth of formation _____

Why _____

Drillers Remarks: _____

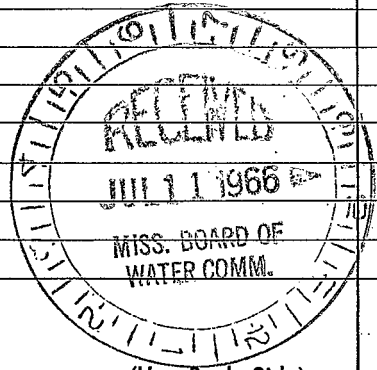

(Use Back Side)

Well No.

