

Marion  
76  
11-67

MISSISSIPPI  
BOARD OF WATER COMMISSIONERS CODED  
416 North State Street  
Jackson, Mississippi 39201

WATER WELL DRILLERS LOG

Nov 26 1967 Fitzgerald Water Well Marion  
date well completed firm name county well located

LANDOWNER: Pl. Robbins

description of formations encountered	from	to
top side clay	0	25
Sand	25	80
Sand & gravel	80	130
White Chalk	130	180
Fine Sand	180	230
Medium Sand	230	240
Gravel & Sand	240	241

(mailing address)

WELL LOCATION:

sec 31 T 4 N 19 E X  
S 5 W 1  
5 miles (distance) NW of Edwards (direction) (nearest town)

WELL PURPOSE: home  
(home, irrigation, municipal, industrial)


WELL COMPLETION DATA:

- (1) diameter (inches) 4
- (2) total depth (feet) 246
- (3) static water level (feet) 160 below top of ground.
- (4) casing plastic 240' (material) (depth)  
4 (size) if telescope see back.
- (5) screen 6' 240' (length) (depth to top)  
4 plastic (size) (material)
- (6) pump — (HP) — (yield gpm)  
Elec (type power)
- (7) electric log no (yes or no)

(organization running log)


(8) how well bottom plugged Wood Peg

DRILLERS REMARKS:

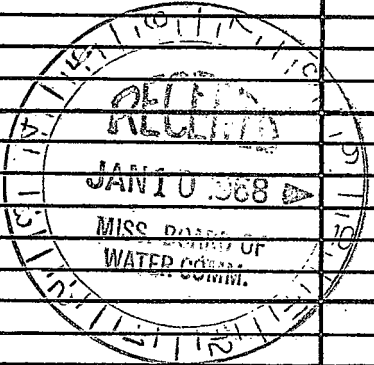

If well telescopes please sketch and show depths.

GROUND LEVEL

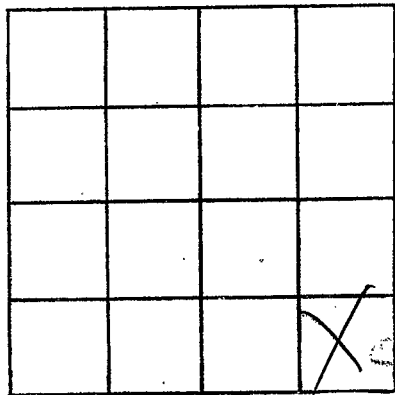

SECTION 31

Please indicate well location X.

ADDITIONAL INFORMATION

If more than one screen, show locations of each on sketch.