

Marion
 F 9
 2-17-70

MISSISSIPPI
 BOARD OF WATER COMMISSIONERS
 416 North State Street
 Jackson, Mississippi 39201

CODED

WATER WELL DRILLERS LOG

2/17 1970 Dean Grimes Marion
 date well completed firm name county well located

LANDOWNER:

C. B. Smith

description of formations encountered

from to

Route 2, Popworth, Miss
 (mailing address)

Top soil

0-1

WELL LOCATION:

sec 11 T 3 N R 13 E
8 miles S of Popworth
 (distance) (direction) (nearest town)

Red clay

1-31

Red sand

21-45

Gravel

45-150

WELL PURPOSE: Home Use
 (home, irrigation, municipal, industrial)

Water sand & P gravel

150-232

WELL COMPLETION DATA:

(1) diameter (inches) 4"

(2) total depth (feet) 232'

(3) static water level (feet) _____ below/above top of ground.

(4) casing Plastic, 2 1/2"
 (material) (depth)

_____ if telescope see back.
 (size)

(5) screen 10', 2 1/2"
 (length) (depth to top)

4", Plastic
 (size) (material)

(6) pump 1 H.P.
 (HP) (yield gpm)

F.B.M. subs. Pump
 (type power)

(7) electric log No
 (yes or no)

 (organization running log)

(8) how well bottom plugged _____

DRILLERS REMARKS:


CODED

MAR 18 1970

MISS. Bd. of
 WATER COMM.

If well telescopes please sketch and show depths.

GROUND LEVEL

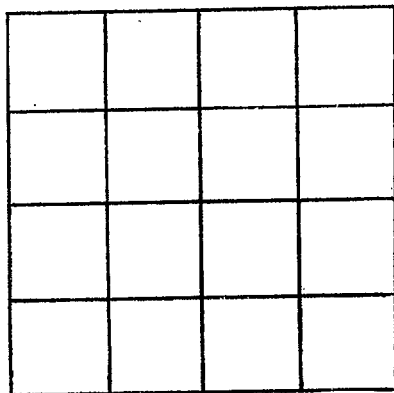

SECTION _____

Please indicate well location X.

ADDITIONAL INFORMATION

If more than one screen, show locations of each on sketch.