

MARION
F10
7-70

MISSISSIPPI
BOARD OF WATER COMMISSIONERS
416 North State Street
Jackson, Mississippi 39201

WATER WELL DRILLERS LOG

CODED

July 1970 E.B. SHERRARD MARION
date well completed firm name county well located

LANDOWNER:		description of formations encountered	from	to
(mailing address)				
CLEM STAMPLEY FOXWORTH, MISS.		VERY DRY COARSE SAND & GRAVEL	140	140
WELL LOCATION: sec 25 T. 4 N. R. 19 E. S. 1 5 1/2 miles NW of Foxworth (distance) (direction) (nearest town)		PEA GRAVEL CLAY-LINED THEN GRAY WITH BLUE MIXED & CRUMBLY	140	145
WELL PURPOSE: (Home, Irrigation, municipal, industrial)		QUICK CHANGE TO COARSE SAND AND PEA GRAVEL	145	210
WELL COMPLETION DATA:				
(1) diameter (inches) 2"				
(2) total depth (feet) 224				
(3) static water level (feet) 152 below top of ground.				
(4) casing PLASTIC, 219 (material) (depth) 2" (size) if telescope see back.				
(5) screen 3' (length) (depth to top) 2" S.S. (size) (material)				
(6) pump 2 (HP) 5 (yield gpm) E (type power)				
(7) electric log (yes or no) (organization running log)				
(8) how well bottom plugged BWV				

CODED


AUG 13 1970

DRILLERS REMARKS:

MISS. BD. OF WATER

If well telescopes please sketch and show depths.

GROUND LEVEL

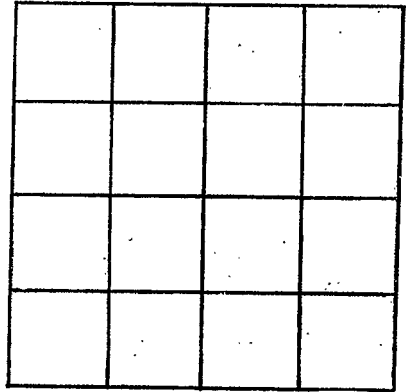

SECTION _____

Please indicate well location X.

ADDITIONAL INFORMATION

A series of horizontal lines for writing additional information.

If more than one screen, show locations of each on sketch.