

MISSISSIPPI
BOARD OF WATER COMMISSIONERS
416 North State Street
Jackson, Mississippi 39201

WATER WELL DRILLERS LOG

CODED

Marion
F-11
7-71

July 19 71 E. B. SHERARD Marion
date well completed firm name county well located

LANDOWNER:
SARAH TERRELL
Rt. 4 COLUMBIA
(mailing address)

description of formations encountered	from	to
RED SANDY CLAY	0	35
GRAVEL & SAND	35	48
BLUE CLAY	48	170
FINE SAND	170	190
COARSE SAND	190	202

WELL LOCATION:
sec. 12 T 4 N R 19 E
S W
4 miles N of COLUMBIA
(distance) (direction) (nearest town)

WELL PURPOSE:
(home) irrigation, municipal, industrial

- WELL COMPLETION DATA:
- (1) diameter (inches) 2"
 - (2) total depth (feet) 202
 - (3) static water level (feet) 70 below above top of ground.
 - (4) casing PL 197
(material) (depth)
2" if telescope see back.
(size)
 - (5) screen 5' PL
(length) (depth to top)
2" PL
(size) (material)
 - (6) pump 3/4 8
(HP) (yield gpm)
E
(type power)
 - (7) electric log (yes or no)
(organization running log)
 - (8) how well bottom plugged BWV

CODED


SEP 15 1971

MISS. BD. OF
WATER COMM.

DRILLERS REMARKS:

If well telescopes please sketch and show depths.

GROUND LEVEL

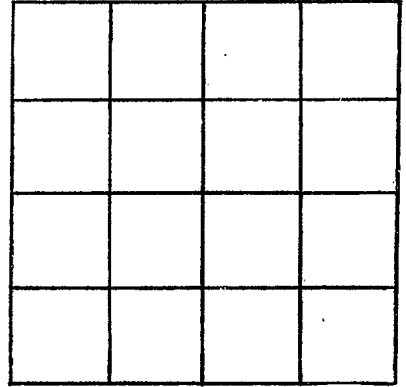

SECTION _____

Please indicate well location X.

ADDITIONAL INFORMATION

If more than one screen,
show locations of each on sketch.