

MARION
F 12
4-72

MISSISSIPPI
 BOARD OF WATER COMMISSIONERS
 416 North State Street
 Jackson, Mississippi 39201

WATER WELL DRILLERS LOG

CODED

April 1972 E.B. Sherrard Marion
 date well completed firm name county well located

LANDOWNER:
Morris Acovito
Columbia, Miss.
 (mailing address)

description of formations encountered	from	to
SAND	0	27
GRAY CLAY	27	70
GR. SAND		
WITH FINE SAND	70	110
COARSE SAND +		
DEA GR.	110	124

WELL LOCATION:
 sec. 1 T. 4 N. R. 19 E.
4 miles N of Columbia
 (distance) (direction) (nearest town)

WELL PURPOSE:
 (home) irrigation, municipal, industrial

- WELL COMPLETION DATA:
- (1) diameter (inches) 2"
 - (2) total depth (feet) 124'
 - (3) static water level (feet) 120' below above top of ground.
 - (4) casing pl. 119'
 (material) (depth)
2" if telescope see back.
 (size)
 - (5) screen 5'
 (length) (depth to top)
2" pl.
 (size) (material)
 - (6) pump 1 7
 (HP) (yield gpm)
E
 (type power)
 - (7) electric log (yes or no)
 (organization running log)
 - (8) how well bottom plugged Bwo

CODED


JUL 28 1972

DRILLERS REMARKS:

MISS. BD. OF
 WATER COMM.

If well telescopes please sketch and show depths.

GROUND LEVEL

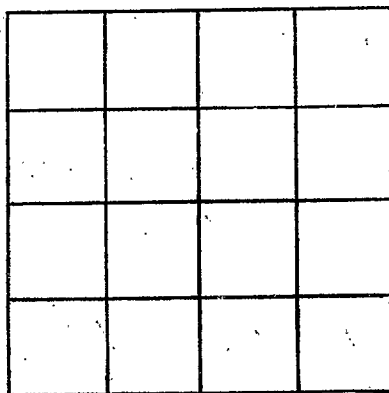

SECTION _____

Please indicate well location X.

ADDITIONAL INFORMATION

If more than one screen, show locations of each on sketch.