

MARION
F13
1-73

MISSISSIPPI
BOARD OF WATER COMMISSIONERS
416 North State Street
Jackson, Mississippi 39201

COPIED

WATER WELL DRILLERS LOG


Jan. 19 73 E.B. Sherrard Marion
date well completed firm name county/well located

LANDOWNER:	description of formations encountered	from	to
William Davis			
Jayworth, Miss. (mailing address)	CLAY	80	190
	BRAZIL SANDY		
	CLAY		
WELL LOCATION:			
sec 31 T 4 N R 13 E 6 miles NW Jayworth (distance) (direction) (nearest town)	SAND & PEACH	190	248
WELL PURPOSE:			
(home) irrigation, municipal, industrial			
WELL COMPLETION DATA:			
(1) diameter (inches) 4"			
(2) total depth (feet) 248'			
(3) static water level (feet) 228' below top of ground. 170' above			
(4) casing (material) pl. (depth) 238'			
4" (size) if telescope see back.			
(5) screen (length) 10' (depth to top)			
4" (size) pl. (material)			
(6) pump 1 (HP) 10 (yield gpm)			
E (type power)			
(7) electric log (yes or no) (yes)			
(organization running log)			
(8) how well bottom plugged BWV			
DRILLERS REMARKS:			

COPIED

If well telescopes please sketch and show depths.

GROUND LEVEL

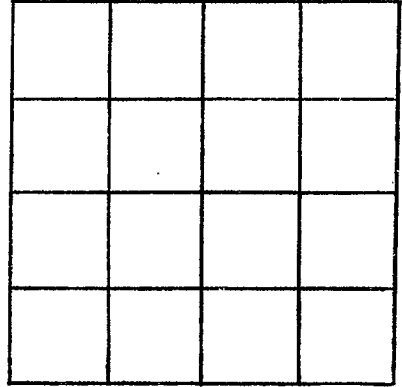

SECTION _____

Please indicate well location X.

ADDITIONAL INFORMATION

If more than one screen,
show locations of each on sketch.