

MARION
F 14
8/73

MISSISSIPPI
BOARD OF WATER COMMISSIONERS
416 North State Street
Jackson, Mississippi 39201

CODED

WATER WELL DRILLERS LOG

Aug 23 1973 E. B. Sheppard Marion
date well completed firm name county well located

LANDOWNER: Bud Garner
Fayward, Miss.
(mailing address)

description of formations encountered SAND & GRAVEL from 0 to 48'


WELL LOCATION:
sec. 17 T. 4 N R. 13 E
1/2 miles N Morgantown
(distance) (direction) (nearest town)

WELL PURPOSE:
(home) irrigation, municipal, industrial

- WELL COMPLETION DATA:
- (1) diameter (inches) 4"
 - (2) total depth (feet) 48'
 - (3) static water level (feet) 26' below top of ground.
 - (4) casing (material) pl. (depth) 38'
 - 4" if telescope see back. (size)
 - (5) screen (length) 10' (depth to top) 4" (size) pl. (material)
 - (6) pump 2 hp. (HP) 15 (yield gpm)
 - 2 (type power)
 - (7) electric log (yes or no) (yes)
 - (organization running log)
 - (8) how well bottom plugged BLW

CODED


DRILLERS REMARKS:

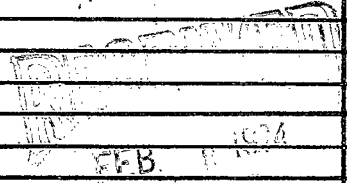

MISS. Bd. of Water Comm.

If well telescopes please sketch and show depths.

GROUND LEVEL

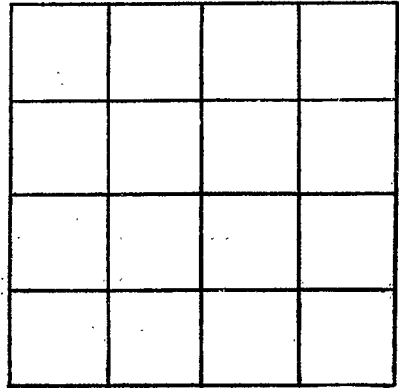

SECTION _____

Please indicate well location X.

ADDITIONAL INFORMATION

If more than one screen, show locations of each on sketch.