

MARION  
F 15  
4/74

MISSISSIPPI  
BOARD OF WATER COMMISSIONERS  
416 North State Street  
Jackson, Mississippi 39201

CODED

WATER WELL DRILLERS LOG

April 1974 E.B. Sheppard Marion  
date well completed firm name county well located

LANDOWNER:	description of formations encountered	from	to
Maggie Auerett Rt. 4 - Columbia, Miss. (mailing address)	GRAVEL & CLAY BLUE CLAY SAND & PEA GR.	0 30 110	30 140 175

WELL LOCATION:  
sec. 12 T. 4 N. R. 19 E.  
4 miles N of Columbia  
(distance) (direction) (nearest town)

WELL PURPOSE:  
(home, irrigation, municipal, industrial)

- WELL COMPLETION DATA:
- (1) diameter (inches) 2"
  - (2) total depth (feet) 175'
  - (3) static water level (feet) 60' below top of ground.
  - (4) casing (material) pl. (depth) 170'
  - 2" (size) if telescope see back.
  - (5) screen 5' pl. (length) (depth to top)
  - 2" (size) pl. (material)
  - (6) pump 1 (HP) 7 (yield gpm)
  - E (type power)
  - (7) electric log (yes or no)
  - (organization running log)
  - (8) how well bottom plugged BWR

DRILLERS REMARKS:


CODED

REGISTERED  
JUL - 1 1974

MISS. BD. OF WATER COMM

If well telescopes please sketch and show depths.

GROUND LEVEL

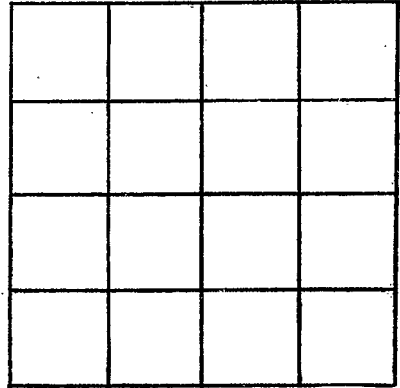

SECTION \_\_\_\_\_

Please indicate well location X.

ADDITIONAL INFORMATION

If more than one screen, show locations of each on sketch.