

MARION  
F16  
1/79

MISSISSIPPI  
BOARD OF WATER COMMISSIONERS  
416 North State Street  
Jackson, Mississippi 39201

CODED

WATER WELL DRILLERS LOG

Jan. 1974 E. B. Sheard Marion  
date well completed firm name county/well located

LANDOWNER:  
W. S. Stevens  
Morgantown, Ms.  
(mailing address)

| description of formations encountered | from | to  |
|---------------------------------------|------|-----|
| SAND + GR.                            | 0    | 30  |
| BLUE CLAY                             | 30   | 120 |
| COARSE SAND + FEA GR.                 | 120  | 142 |

WELL LOCATION:  
sec 21 T 4 N R 13E  
S  
4 miles N of Smith  
(distance) (direction) (nearest town)

WELL PURPOSE:  
(home) irrigation, municipal, industrial

CODED

- WELL COMPLETION DATA:
- (1) diameter (inches) 2"
  - (2) total depth (feet) 142'
  - (3) static water level (feet) 12' <sup>below</sup> above top of ground.
  - (4) casing (material) pl. (depth) 137'
  - 2" (size) if telescope see back.
  - (5) screen 5' (length) (depth to top)
  - 2" (size) (material) pl.
  - (6) pump 1/3 (HP) 8 (yield gpm)
  - E (type power)
  - (7) electric log (yes or no) (no)
  - (organization running log)
  - (8) how well bottom plugged BWR


RECEIVED  
JUL - 1 1974

DRILLERS REMARKS:

MISS. BD. OF WATER COMMISSIONERS

If well telescopes please sketch and show depths.

GROUND LEVEL

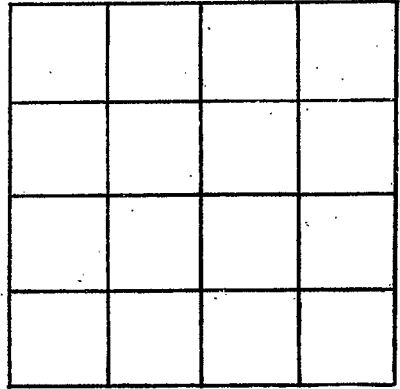

SECTION \_\_\_\_\_

Please indicate well location X.

ADDITIONAL INFORMATION

If more than one screen, show locations of each on sketch.