

MARION
 F17
 5-21-74

MISSISSIPPI
 BOARD OF WATER COMMISSIONERS
 416 North State Street
 Jackson, Mississippi 39201


CODED

WATER WELL DRILLERS LOG

5-21 1974 Unimer - Minn Marion
 date well completed firm name county well located.

LANDOWNER:	description of formations encountered	from	to
<u>Amos Neal</u> <u>Rt. 1</u> <u>Forworth</u> (mailing address) <u>Miss.</u>	<u>Top Soil</u> <u>clay</u> <u>clay & gravel</u> <u>shell</u> <u>sand & gravel</u>	<u>0</u> <u>1</u> <u>35</u> <u>130</u> <u>160</u>	<u>1</u> <u>35</u> <u>130</u> <u>160</u> <u>207</u>
WELL LOCATION: sec. <u>6</u> T. <u>4</u> N R. <u>19</u> E <u>8 1/2</u> miles <u>NW</u> of <u>Forworth</u> (distance) (direction) (nearest town)			
WELL PURPOSE: <u>HOME</u> (home, irrigation, municipal, industrial)			
WELL COMPLETION DATA: (1) diameter (inches) <u>4"</u> (2) total depth (feet) <u>203</u> (3) static water level (feet) <u>138</u> below above top of ground. (4) casing <u>plastic</u> , <u>193</u> (material) (depth) <u>4"</u> If telescope see back. (size) (5) screen <u>10'</u> , <u>193</u> (length) (depth to top) <u>4"</u> , <u>plastic</u> (size) (material) (6) pump <u>3/4</u> , <u>12</u> (HP) (yield gpm) <u>elec</u> (type power) (7) electric log <u>NO</u> (yes or no) <u>NO</u> (organization running log) (8) how well bottom plugged: <u>B.W. Valve</u>			
DRILLERS REMARKS:			

CODED

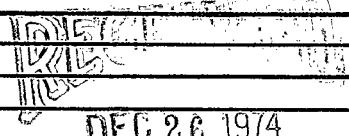

If well telescopes please sketch and show depths.

GROUND LEVEL



SECTION 6

Please indicate well location X.

ADDITIONAL INFORMATION

If more than one screen, show locations of each on sketch.