

MARION  
F 18  
1-30-75

MISSISSIPPI  
BOARD OF WATER COMMISSIONERS  
416 North State Street  
Jackson, Mississippi 39201

CODED

WATER WELL DRILLERS LOG

1-30-75 date well completed  
GRINER DRILLING SERVICE firm name  
MARION county well located

LANDOWNER: NEW & Hughes  
Rig # 8, DRILLING CONTRACTOR  
JACK E. STACK, JR., No. 1  
UNIT # 29 (mailing address)

WELL LOCATION: 1120' N + 60' E  
sec. 27 T. 4 N. R. 13 E of SW  
S W C&R  
\_\_\_\_\_ miles \_\_\_\_\_ of \_\_\_\_\_  
(distance) (direction) (nearest town)

WELL PURPOSE: oil well supply  
(home, irrigation, municipal, industrial)

- WELL COMPLETION DATA:
- (1) diameter (inches) 3
  - (2) total depth (feet) 504 ft.
  - (3) static water level (feet) 75' below  
top of ground.
  - (4) casing B.I. 483  
(material) (depth)  
3"  
(size) if telescope see back.
  - (5) screen 21' 483  
(length) (depth to top)  
3" B.I. slotted pipe  
(size) (material)
  - (6) pump Air Comp. 75  
(HP) (yield gpm)  
Air Comp.  
(type power)
  - (7) electric log No.  
(yes or no)  
No  
(organization running log)
  - (8) how well bottom plugged plugged


description of formations encountered	from	to
TOP SOIL	0	3
CLAY	3	60
SAND & GRAVEL	60	100
CLAY	100	190
SAND & GRAVEL	190	225
CLAY	225	244
SAND	244	264
CLAY	264	266
SAND	266	504
CLAY	504	550

DRILLERS REMARKS: \_\_\_\_\_

MISS. BD. OF WATER COMMISSIONERS

If well telescopes please sketch and show depths.

GROUND LEVEL

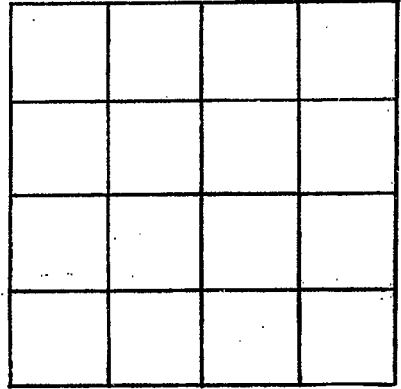

SECTION \_\_\_\_\_

Please indicate well location X.

ADDITIONAL INFORMATION

If more than one screen,  
show locations of each on sketch.