

MARION
F21
119179

MISSISSIPPI
BOARD OF WATER COMMISSIONERS
416 North State Street
Jackson, Mississippi 39201

CODED

WATER WELL DRILLERS LOG

1/19 1979 Griner Drilling Marion
date well completed firm name county well located

LANDOWNER:
Louisiana Land & Exploration
P.O. Box 60350
New Orleans, La. 70160
(mailing address)

description of formations encountered.	from	to
Top soil - sand	0	100
Chalk	0	430
Sand	430	465

WELL LOCATION: 1357' N 2337' E
sec. 19 T-4 N R-13 S
1/4 miles S-SW of Morgantown
(distance) (direction) (nearest town)

WELL PURPOSE: oil field supply
(home, irrigation, municipal, industrial)

CODED


- WELL COMPLETION DATA:
- (1) diameter (inches) 3"
 - (2) total depth (feet) 465'
 - (3) static water level (feet) 150' ^{below} above top of ground.
 - (4) casing steel, 465' (material) (depth) 2'
3" (size) if telescope see back.
 - (5) screen 42' 423' (length) (depth to top)
3" perforated (size) (material)
 - (6) pump 75 (HP) (yield gpm)
AC (type power)
 - (7) electric log (yes or no)
 - (organization running log)
 - (8) how well bottom plugged orange
peel

RECEIVED
JAN 24 1979

DRILLERS REMARKS:

If well telescopes please sketch and show depths.

GROUND LEVEL

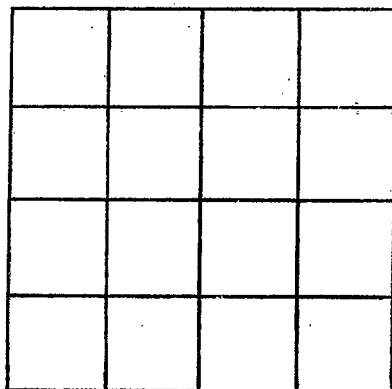

SECTION _____

Please indicate well location X.

ADDITIONAL INFORMATION

If more than one screen,
show locations of each on sketch.