

MARION  
F23  
8-31-79

MISSISSIPPI  
BOARD OF WATER COMMISSIONERS  
416 North State Street  
Jackson, Mississippi 39201

CODED

WATER WELL DRILLERS LOG

8-31-79 Griner Drilling MARION  
date well completed firm name county well located

LANDOWNER:  
Tomlinson Interest  
Houston National Gas Bldg  
Houston, TX.  
(mailing address)

description of formations encountered	from	to
gravel	0	126
chert	126	210
sand	210	315

WELL LOCATION: fr SW/4 Cor Sec 15  
sec. 15 T. 40 N R. 13 E  
Morgantown Foxworth  
(distance) (direction) (nearest town)

WELL PURPOSE: Oil field supply  
(home, irrigation, municipal, industrial)

CODED

- WELL COMPLETION DATA:
- (1) diameter (inches) 4"
  - (2) total depth (feet) 315'
  - (3) static water level (feet) 0 below top of ground.
  - (4) casing steel, 315' (material) (depth)  
4" (size) if telescope see back.
  - (5) screen 42', 273' (length) (depth to top)  
4" perforated (size) (material)
  - (6) pump — 90 (HP) (yield gpm)  
AC (type power)
  - (7) electric log — (yes or no)

(organization running log)  
(8) how well bottom plugged Orange peel

DRILLERS REMARKS:


Miss. Board of Water Comm.

SEP 17 1979

RECEIVED

If well telescopes please sketch and show depths.

GROUND LEVEL

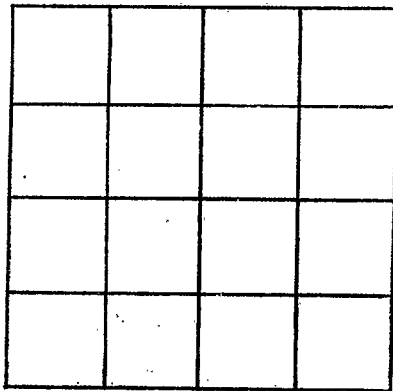

SECTION \_\_\_\_\_

Please indicate well location X.

ADDITIONAL INFORMATION

If more than one screen, show locations of each on sketch.