

MARION  
 F-24  
 10-15-79

MISSISSIPPI  
 BOARD OF WATER COMMISSIONERS CODED  
 416 North State Street  
 Jackson, Mississippi 39201

WATER WELL DRILLERS LOG

10-15-79 date well completed  
 Griner Drilling Marion firm name  
 county well located

LANDOWNER: Florida Gas Exploration  
 1444 Capital Towers  
 Jackson, MS 39201  
 (mailing address)

description of formations encountered: Sand + pea gravel  
 from: 0 to: 309

WELL LOCATION: 1500' S + 1700' E  
 Newson Field Sec. 4 T. 4 N. R. 19 W. of Goss  
 SW of Goss  
 (distance) (direction) (nearest town)

WELL PURPOSE: oil field supply  
 (home, irrigation, municipal, industrial)

WELL COMPLETION DATA:

- (1) diameter (inches) 3"
- (2) total depth (feet) 309'
- (3) static water level (feet) 25' <sup>below</sup> top of ground
- (4) casing steel 275' (material) (depth)  
 3" (size) if telescope see back.
- (5) screen 42', 233' (length) (depth to top)  
 3" perforated (size) (material)
- (6) pump — 80 (HP) (yield gpm)  
 AC (type power)
- (7) electric log — (yes or no)

(organization running log)


(8) how well bottom plugged peel orange

DRILLERS REMARKS:

RECEIVED  
 NOV 18 1979

If well telescopes please  
sketch and show depths.

GROUND LEVEL

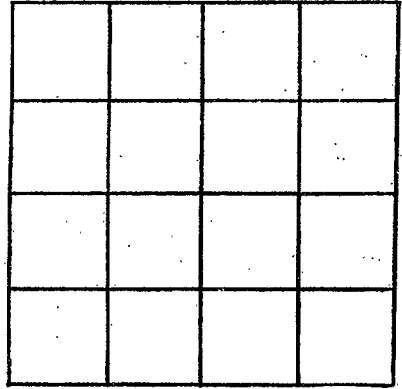

SECTION \_\_\_\_\_

Please indicate well location X.

ADDITIONAL INFORMATION

If more than one screen,  
show locations of each on sketch.