

MARION  
F 25  
11/5/79

MISSISSIPPI  
BOARD OF WATER COMMISSIONERS  
416 North State Street  
Jackson, Mississippi 39201

CODED

WATER WELL DRILLERS LOG

11-5 79 Griner Drilling Marion  
date well completed firm name county well located

LANDOWNER:

Tomlinson Interest  
2201 Hardy St.  
Battiesburg, MS  
(mailing address)

description of formations encountered

from to

gravel	0	42
chalk	42	70
gravel	70	168
chalk	168	210
pea-gravel	210	273

WELL LOCATION: 250' N + 90' E

11-22-40 R 130' SW 1/4 of  
Morgantown - Foxworth  
(distance) (direction) (nearest town)

WELL PURPOSE: oil field supply  
(home, irrigation, municipal, industrial)

WELL COMPLETION DATA:

- (1) diameter (inches) 4"
- (2) total depth (feet) 273'
- (3) static water level (feet) <sup>flowing</sup> above top of ground.
- (4) casing 273' steel casing  
(material) (depth)  
4" (size) if telescope see back.
- (5) screen 42' 231'  
(length) (depth to top)  
4" (size) perforated (material)
- (6) pump 95  
(HP) (yield gpm)  
AC (type power)
- (7) electric log (yes or no)
- (organization running log)

CODED

(8) how well bottom plugged orange


DRILLERS REMARKS:

DEPT. OF NATURAL RESOURCES  
BUREAU OF LAND & WATER RESOURCES

DEC 19 1979  
RECEIVED

If well telescopes please sketch and show depths.

GROUND LEVEL

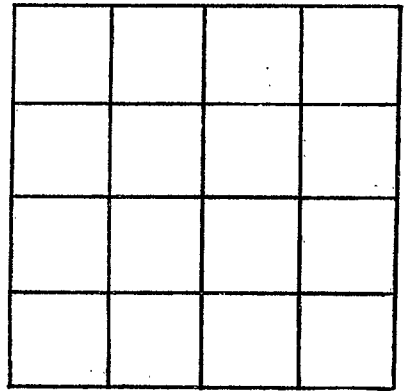

SECTION \_\_\_\_\_

Please indicate well location X.

ADDITIONAL INFORMATION

If more than one screen, show locations of each on sketch.