

MARION  
 F-26  
 12-31-79

MISSISSIPPI  
 BOARD OF WATER COMMISSIONERS  
 416 North State Street  
 Jackson, Mississippi 39201

WATER WELL DRILLERS LOG

12-31 1979 Holliman MARION  
 date well completed firm name county well located

LANDOWNER: Vernon Beal  
Hwy 98 W  
Foxworth, MS  
 (mailing address)

description of formations encountered	from	to
Clay, chalk, sand	0	20
CHALK	20	160
sand, chalk	200	260
sand, pea gravel	260	320

WELL LOCATION:  
 sec. 29 T 46 N R. 19  
2 miles S of Lumberton  
 (distance) (direction) (nearest town)

WELL PURPOSE: Business  
 (home, irrigation, municipal, industrial)

- WELL COMPLETION DATA:
- (1) diameter (inches) 4
  - (2) total depth (feet) 320
  - (3) static water level (feet) Flow below top of ground.
  - (4) casing PVC (material), (depth)  
 (size) if telescope see back.
  - (5) screen 20, 300 (length) (depth to top)  
4 PVC (size) (material)
  - (6) pump NO (HP) 125 (yield gpm)  
Free Flow (type power)
  - (7) electric log (yes or no)
  - (8) how well bottom plugged float

DRILLERS REMARKS: Very good well


DEPT. OF NATURAL RESOURCES  
 BUREAU OF LAND & WATER RESOURCES

JAN 15 1980

RECEIVED

If well telescopes please sketch and show depths.

GROUND LEVEL

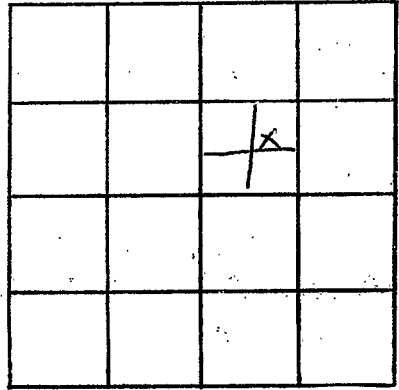

SECTION 27

Please indicate well location X.

ADDITIONAL INFORMATION

If more than one screen, show locations of each on sketch.