

Marion  
F-27  
12-31-79  
12-31-79

MISSISSIPPI  
 BOARD OF WATER COMMISSIONERS  
 416 North State Street  
 Jackson, Mississippi 39201

CODED

WATER WELL DRILLERS LOG

12-31-79 Griner Drilling Marion  
 date well completed firm name county well located

LANDOWNER:

Tomlinson Interest  
2201 Hardy St  
Cottlesberg, MS 39401  
 (mailing address)

description of formations encountered

from to

|               |     |     |
|---------------|-----|-----|
| chalk         | 0   | 42  |
| sand + gravel | 42  | 147 |
| chalk         | 147 | 189 |
| sand-gravel   | 189 | 273 |

WELL LOCATION:

NO 1  
 C.V. Morgan

1500'S & 1568' W  
21 T 40 R 13 E O F  
Morgantown, MS  
 (distance) (direction) (nearest town)

WELL PURPOSE:

(home, irrigation, municipal, industrial)

WELL COMPLETION DATA:

- (1) diameter (inches) 4"
- (2) total depth (feet) 273'
- (3) static water level (feet) Flowing  
top of ground. (above)
- (4) casing Steel, 273'  
(material) (depth)  
4"  
(size) If telescope see back.
- (5) screen 42', 231'  
(length) (depth to top)  
4" perforated  
(size) (material)
- (6) pump —, 80  
(HP) (yield gpm)  
AC  
(type power)
- (7) electric log —  
(yes or no)

(organization running log)

- (8) how well bottom plugged orange  
peel

DRILLERS REMARKS:


DEPT. OF NATURAL RESOURCES  
 BUREAU OF LAND & WATER RESOURCES

JAN 24 1980

RECEIVED

If well telescopes please sketch and show depths.

GROUND LEVEL

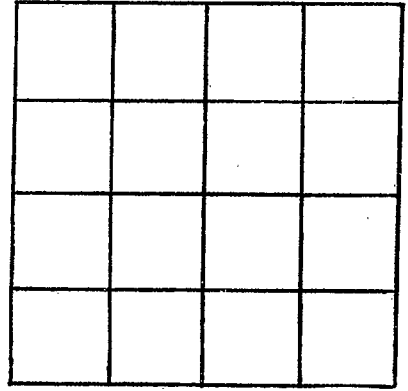

SECTION \_\_\_\_\_

Please indicate well location X.

ADDITIONAL INFORMATION

If more than one screen,  
show locations of each on sketch.