

MARION
 F-28
 12-23-79
 12-23-79

MISSISSIPPI
 BOARD OF WATER COMMISSIONERS
 416 North State Street
 Jackson, Mississippi 39201

CODED

WATER WELL DRILLERS LOG

12-23-79 Griner Drilling Marion
 date well completed firm name county well located

LANDOWNER:

Mosbacher Production

description of formations encountered

from to

sand & gravel 0 168
 chalk 168 420
 sand & gravel 420 546

(mailing address)

WELL LOCATION: 1500' N + 1020' E

Fernwood
 Lumber
 Company

29 T 4 N R 13 E of SW/COV

Morgan town

(distance) (direction) (nearest town)

WELL PURPOSE: oil field
 (home, irrigation, municipal, industrial)


WELL COMPLETION DATA:

- (1) diameter (inches) 3"
- (2) total depth (feet) 546'
- (3) static water level (feet) 80' below top of ground.
- (4) casing steel 546' (material) (depth)
 3" (size) if telescope see back.
- (5) screen 42' 504' (length) (depth to top)
 3" perforation (size) (material)
- (6) pump — 75 (HP) (yield gpm)
 AC (type power)
- (7) electric log — (yes or no)
 (organization running log)
- (8) how well bottom plugged peel orange

DRILLERS REMARKS:

If well telescopes please sketch and show depths.

GROUND LEVEL

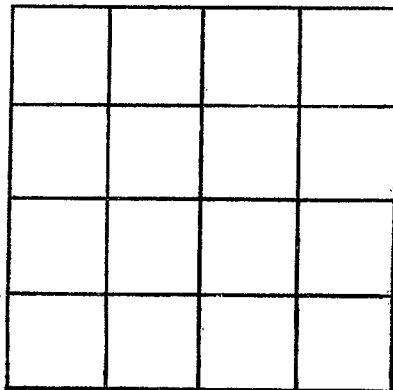

SECTION _____

Please indicate well location X.

ADDITIONAL INFORMATION

If more than one screen,
show locations of each on sketch.