

Marion
F-29
3-26-80

MISSISSIPPI
 BOARD OF WATER COMMISSIONERS
 416 North State Street
 Jackson, Mississippi 39201

CODED

WATER WELL DRILLERS LOG

date well completed 3-26-80 firm name Griner Drilling county well located Marion

LANDOWNER:
Larco Drilling
1700 Capital Towers
Jackson, MS 39205
 (mailing address)

description of formations encountered	from	to
<u>Clay, gravel</u>	<u>0</u>	<u>42</u>
<u>gravel, sand</u>	<u>42</u>	<u>320</u>
	<u>320</u>	

NO. 109 of 3 T. 4N R. 19E S. 10W
 3-11 East Morgan Field
 (distance) (direction) (nearest town)

WELL PURPOSE: oil field supply
 (home, irrigation, municipal, industrial)

WELL COMPLETION DATA:
 (1) diameter (inches) 3"
 (2) total depth (feet) 320'
 (3) static water level (feet) 50' below above top of ground.
 (4) casing steel 305'
 (material) (depth)
3" if telescope see back.
 (size)
 (5) screen 42' 263'
 (length) (depth to top)
3" perforated
 (size) (material)
 (6) pump - 100
 (HP) (yield gpm)
AC
 (type power)
 (7) electric log -
 (yes or no)
 (organization running log)

CODED

(8) how well bottom plugged orange
peel
 DRILLERS REMARKS:


DEPT. OF NATURAL RESOURCES
 BUREAU OF LAND & WATER RESOURCES

APR 21 1980

RECEIVED

If well telescopes please sketch and show depths.

GROUND LEVEL

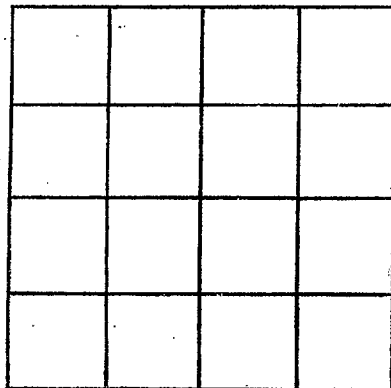

SECTION _____

Please indicate well location X.

ADDITIONAL INFORMATION

If more than one screen, show locations of each on sketch.