

MARION

F-30
5-1-80

MISSISSIPPI
BOARD OF WATER COMMISSIONERS
416 North State Street
Jackson, Mississippi 39201

CODED

WATER WELL DRILLERS LOG

5-1-80 Griner Drilling Marion

date well completed

firm name

county well located

LANDOWNER:
Louisiana Land & Exploration
P.O. Box 60350
New Orleans, La. 70160
(mailing address)

description of formations encountered

from

to

Sand - Pea gravel	0	42
clay-rocks-sand	42	350
sand	350	415
clay-sand	415	490
sand CODED	490	525
clay	525	750
sand	750	850
clay	850	861

WELL LOCATION: 2125'N 12825'W
No 2 18 T 40 R 13 E of
Hawberg Morgan town sec/cor
(distance) (direction) (nearest town)

WELL PURPOSE: oil field supply
(home, irrigation, municipal, industrial)

WELL COMPLETION DATA:

- (1) diameter (inches) 3"
- (2) total depth (feet) 851'
- (3) static water level (feet) 120' below top of ground
- (4) casing steel 840' (material) (depth)
3" (size) If telescope see back.
- (5) screen 42' 798' (length) (depth to top)
3" perforated (size) (material)
- (6) pump 80 (HP) (yield gpm)
AC (type power)
- (7) electric log (yes or no)

(organization running log)

(8) how well bottom plugged orange
peel

DRILLERS REMARKS:


DEPT. OF NATURAL RESOURCES
BUREAU OF LAND & WATER RESOURCES

MAY 20 1980

RECEIVED

If well telescopes please sketch and show depths.

GROUND LEVEL

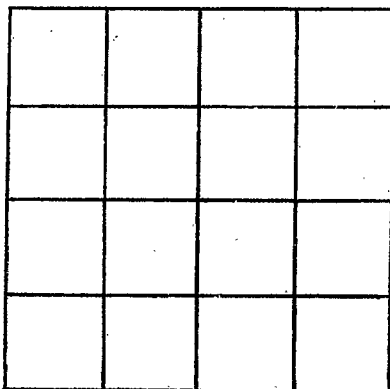

SECTION _____

Please indicate well location X.

ADDITIONAL INFORMATION

If more than one screen, show locations of each on sketch.