

MARION
F35
10/1/80

MISSISSIPPI
BOARD OF WATER COMMISSIONERS
416 North State Street
Jackson, Mississippi 39201

CODED

WATER WELL DRILLERS LOG

Gruber Drilling Services, Inc *Marion*

10-1-80
date well completed

firm name

county well located

LANDOWNER:

Mossbacher Production
2100 Capital Natl. Bank Bldg.
Houston, Texas
(mailing address)

description of formations encountered

from

to

clay + sand 0 21

sand and pea gravel 21 160

clay, sand, mostly clay 160 500

sand, with coarse breakers of clay 500 550

WELL LOCATION:

No 2
Fernwood
Lee Co.
1000 W + 1500' W
T 4 N R 13 E
3 miles NW of *Fernwood*
(distance in miles)

WELL PURPOSE:

oil field supply
(home, irrigation, municipal, industry)

WELL COMPLETION DATA:

- (1) diameter (inches) 3"
- (2) total depth (feet) 550'
- (3) static water level (feet) 150' ^{below} _{above} top of ground.
- (4) casing steel, 550'
(material) (depth)
3"
(size) If telescope see back.
- (5) screen 42', 508'
(length) (depth to top)
3" perforated
(size) (material)
- (6) pump 80
(HP) (yield gpm)
ac
(type power)
- (7) electric log —
(yes or no)

CODED

DEPT. OF NATURAL RESOURCES
BUREAU OF LAND & WATER RESOURCES

(organization running log)

(8) how well bottom plugged *orange peel*


OCT 23 1980

DRILLERS REMARKS:

RECEIVED

If well telescopes please sketch and show depths.

GROUND LEVEL

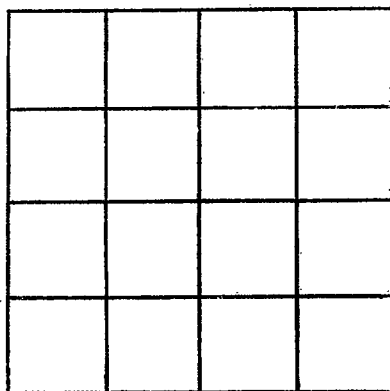

SECTION _____

Please indicate well location X.

ADDITIONAL INFORMATION

If more than one screen,
show locations of each on sketch.