

MISSISSIPPI DEPARTMENT OF NATURAL RESOURCES

Bureau of Land and Water Resources

Southport Mall

P.O. Box 10631

Jackson, Mississippi 39209

WATER WELL DRILLERS LOG

Griner Drilling Service, Inc.

Marion

CODED

MARION
F 36
1-7-81

date well completed

firm name

county well located

LANDOWNER:

Florida Gas
1444 Capital Towers
Jackson, Ms. 39201
(mailing address)

description of formations encountered

from

to

<i>sand + gravel</i>	<i>0</i>	<i>147</i>
<i>clay</i>	<i>147</i>	<i>168</i>
<i>sand + gravel</i>	<i>168</i>	<i>210</i>

WELL LOCATION: *500'S + 2125'W*

no 21 Sec *4* T *4* N R *19* E of *of*
Fannie
B. Carlisle miles *Goss* of *me/cn*
(distance) (direction) (nearest town)

WELL PURPOSE: *oil field*
(home, irrigation, municipal, industrial, *supply*)

WELL COMPLETION DATA:

- (1) diameter (inches) *4"*
- (2) total depth (feet) *210'*
- (3) static water level (feet) *10'* ^{below} ~~above~~ top of ground.
- (4) casing *steel, 210'*
(material) (depth)
4"
(size) if telescope see back.
- (5) screen *42'*, *168'*
(length) (depth to top)
4", *perforated*
(size) (material)
- (6) pump *—* *100*
(HP) (yield gpm)
ac
(type power)
- (7) electric log *—*
(yes or no)

(organization running log)

(8) how well bottom plugged *orange*
peel

DRILLERS REMARKS:


DEPT. OF NATURAL RESOURCES
BUREAU OF LAND & WATER RESOURCES

JAN 26 1981

RECEIVED

If well telescopes please
sketch and show depths.

GROUND LEVEL

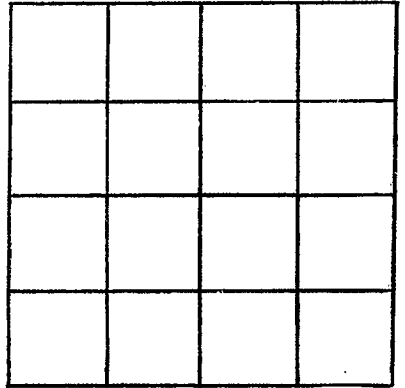

SECTION _____

Please indicate well location X.

ADDITIONAL INFORMATION

If more than one screen,
show locations of each on sketch.