

MISSISSIPPI DEPARTMENT OF NATURAL RESOURCES

Bureau of Land and Water Resources

Southport Mall


P.O. Box 10631

Jackson, Mississippi 39209

WATER WELL DRILLERS LOG

CODED

Griner Drilling Service, Inc

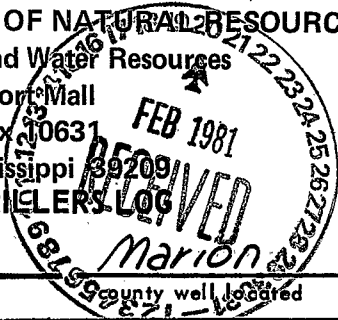

MARION  
F 37  
2/15/81  
2-15-81

date well completed

firm name

LANDOWNER:

Florida Gas & Exploration  
1444 Capital Towers  
Jackson, MS 39201

(mailing address)

description of formations encountered

from

to

pea gravel

0 147

clay

147 231

WELL LOCATION: 1931 S + 818' W of

sec. 17 T 4 R B E NE 1/4

NO 1 C.E. Sibley et al W

Morgan town of

WELL PURPOSE: oil field supply  
(home, irrigation, municipal, industrial)

WELL COMPLETION DATA:

- (1) diameter (inches) 4"
- (2) total depth (feet) 231'
- (3) static water level (feet) 15' below above top of ground.
- (4) casing steel, 147'  
(material) (depth)  
4"  
(size) if telescope see back.
- (5) screen 42', 105'  
(length) (depth to top)  
4", perforated  
(size) (material)
- (6) pump —, 100  
(HP) (yield gpm)  
AC  
(type power)
- (7) electric log —  
(yes or no)

(organization running log)

- (8) how well bottom plugged orange  
peel

DRILLERS REMARKS:


DEPT. OF NATURAL RESOURCES  
BUREAU OF LAND & WATER RESOURCES

FEB 20 1981

RECEIVED

If well telescopes please sketch and show depths.

GROUND LEVEL

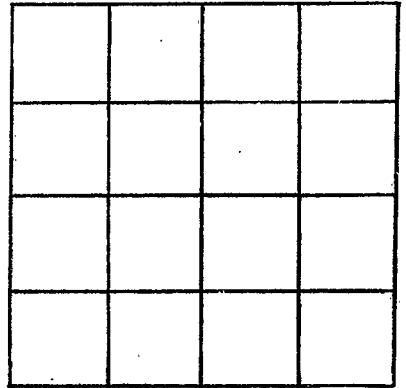

SECTION \_\_\_\_\_

Please indicate well location X.

ADDITIONAL INFORMATION

If more than one screen,  
show locations of each on sketch.