

MISSISSIPPI DEPARTMENT OF NATURAL RESOURCES

Bureau of Land and Water Resources

Southport Mall

P.O. Box 10631

Jackson, Mississippi 39209

WATER WELL DRILLERS LOG

CODED

Marion
F38
4-15-81

Griner Drilling Service, INC.

Marion

date well completed

firm name

county well located

LANDOWNER:

Louisiana Land & Exploration

P.O. Box 60350

New Orleans, La 70160

(mailing address)

description of formations encountered

from

to

sand + pea gravel 0 140

clay 140 500

sand 500 548

WELL LOCATION:

180' N of 1500 W

sec 19 T 40 N

R 13 E of SE 1/4

No. 3 Hauberg

South Morganblow Field

(distance) (direction) (nearest town)

WELL PURPOSE: oil field sample
(home, irrigation, municipal, industrial)

WELL COMPLETION DATA:

(1) diameter (inches) 3"

(2) total depth (feet) 548'

(3) static water level (feet) 100' below top of ground.

(4) casing steel 548' (material) (depth)

3" if telescope see back. (size)

(5) screen 42' 506' (length) (depth to top)

3" perforated (size) (material)

(6) pump 75 (HP) (yield gpm)

AC (type power)


(7) electric log (yes or no)

(organization running log)

(8) how well bottom plugged orange


peel

DRILLERS REMARKS:

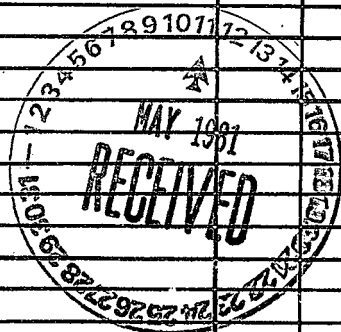

If well telescopes please sketch and show depths.

GROUND LEVEL

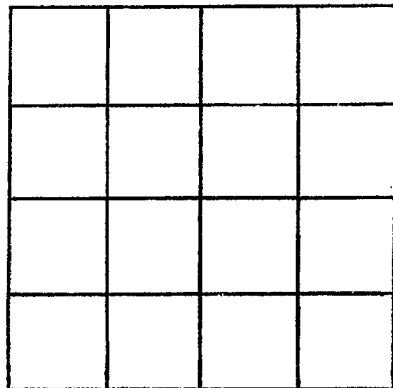

SECTION _____

Please indicate well location X.

ADDITIONAL INFORMATION

If more than one screen, show locations of each on sketch.