

MISSISSIPPI DEPARTMENT OF NATURAL RESOURCES
 Bureau of Land and Water Resources
 Southport Mall
 P.O. Box 10631

Jackson, Mississippi 39209

CODED

WATER WELL DRILLERS LOG

Marion
F39
5-26-81

Griner Drilling Service, Inc. Marion

5-26-81
 date well completed

firm name

county well located

LANDOWNER:	description of formations encountered	from	to
<u>Champlin Petroleum</u> <u>P.O. Box 44</u> <u>Jackson, MS 39205</u> (mailing address)	<u>sand + gravel</u>	<u>0</u>	<u>260</u>
	<u>streaked</u>	<u>260</u>	<u>273</u>
WELL LOCATION: <u>1600' N + 2000' E</u> <u>NO. 1</u> <u>Pages c. 26</u> T- <u>4</u> (N) R- <u>13</u> (E) of <u>Sul/co</u> <u>Morgantown</u> (distance) (direction) (nearest town)			
WELL PURPOSE: <u>oil field</u> (home, irrigation, municipal, industrial, <u>supply</u>)			
WELL COMPLETION DATA:			
(1) diameter (inches) <u>4"</u>			
(2) total depth (feet) <u>273'</u>			
(3) static water level (feet) <u>Flowing</u> top of ground.			
(4) casing <u>steel</u> , <u>252'</u> (material), (depth) <u>4"</u> (size) if telescope see back.			
(5) screen <u>42'</u> , <u>210'</u> (length), (depth to top) <u>4"</u> , <u>perforated</u> (size), (material)			
(6) pump <u>—</u> , <u>100</u> (HP), (yield gpm) <u>ac</u> (type power)			
(7) electric log <u>—</u> (yes or no) <u>—</u> (organization running log)			
(8) how well bottom plugged <u>orange</u> <u>peel</u>			
DRILLERS REMARKS:			

CODED


DEPT. OF NATURAL RESOURCES
 BUREAU OF LAND & WATER RESOURCES

MAY 28 1981

RECEIVED

If well telescopes please sketch and show depths.

GROUND LEVEL

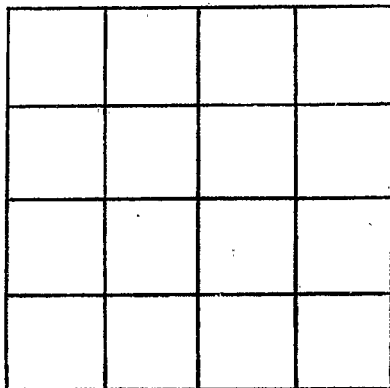

SECTION _____

Please indicate well location X.

ADDITIONAL INFORMATION

If more than one screen, show locations of each on sketch.