

MISSISSIPPI DEPARTMENT OF NATURAL RESOURCES
Bureau of Land and Water Resources

Southport Mall
P.O. Box 10631

CODED

Jackson, Mississippi 39209

WATER WELL DRILLERS LOG

MARION
F40
6-3-81

6-3-81 *Greene Drilling Service, Inc.* *Marion*
date well completed firm name county well located

LANDOWNER:
Champlin Petroleum
P.O. Box 411
Jackson, MS 39205
(mailing address)

description of formations encountered	from	to
<i>sands + gravel</i>	<i>0</i>	<i>210</i>
<i>streaked chalk</i>	<i>210</i>	<i>231</i>

WELL LOCATION: *1500' N + 660' W*
sec 1 T 40 S R 19 E S 1 or 2
of Columbia Field
distance (direction) (nearest town)


<i>sands + gravel</i>	<i>231</i>	<i>315</i>
<i>gravel</i>		

WELL PURPOSE: *oil field supply*
(home, irrigation, municipal, industrial)

CODED

WELL COMPLETION DATA:

- (1) diameter (inches) *4"*
- (2) total depth (feet) *357'*
- (3) static water level (feet) *50'* (below top of ground)
- (4) casing *steel 315'*
(material) (depth)
4" if telescope see back.
(size)
- (5) screen *42' 29.3'*
(length) (depth to top)
4" perforated
(size) (material)
- (6) pump *75*
(HP) (yield gpm)
AC
(type power)
- (7) electric log *—*
(yes or no)

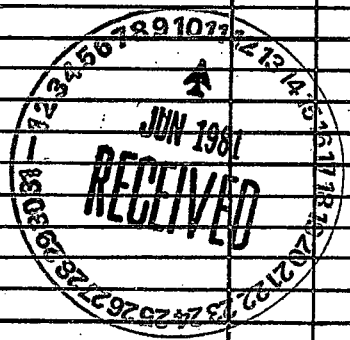


(organization running log)

(8) how well bottom plugged *margin*
peel

DRILLERS REMARKS:

If well telescopes please sketch and show depths.

GROUND LEVEL

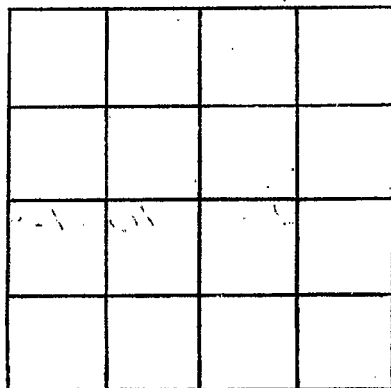

SECTION _____

Please indicate well location X.

ADDITIONAL INFORMATION

If more than one screen,
show locations of each on sketch.