

MISSISSIPPI DEPARTMENT OF NATURAL RESOURCES

Bureau of Land and Water Resources

Southport Mall

P.O. Box 10631

Jackson, Mississippi 39209

WATER WELL DRILLERS LOG

Maion
F 41
6-11-81

6-11-81

Gunter Drilling Service, Inc

Maion

date well completed

firm name

county well located

LANDOWNER:

Louisiana Land Exp.
P.O. Box 60350
New Orleans, La 70160
 (mailing address)

description of formations encountered

from

to

sand, gravel 0 126
chalk 126 210

WELL LOCATION: 2385'N + 3035'W

sec. 29 T. 4N R. 13E of
Clarence South Mangrove
E. Thacker Field
 (distance) (nearest town)

sand, gravel 210 273
chalk 273 357

WELL PURPOSE: oil field supply
 (home, irrigation, municipal, industrial)

streaked, chalk 357 399
sand

WELL COMPLETION DATA:

(1) diameter (inches) 4"
 (2) total depth (feet) 567'
 (3) static water level (feet) 100' below above top of ground.

chalk 399 462
sand, pea gravel 462 567

(4) casing steel, 567'
 (material) (depth)
4"
 (size) if telescope see back.

(5) screen 63', 504'
 (length) (depth to top)
4", perforated
 (size) (material)


(6) pump 80
 (HP) (yield gpm)
AC
 (type power)

(7) electric log —
 (yes or no)
 (organization running log)

(8) how well bottom plugged range
peel


DRILLERS REMARKS:

CODED

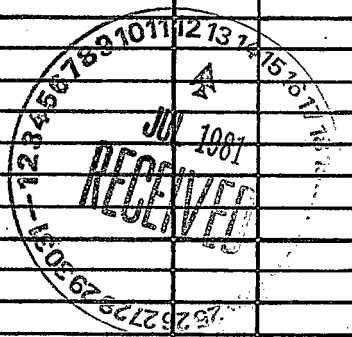

If well telescopes please sketch and show depths.

GROUND LEVEL

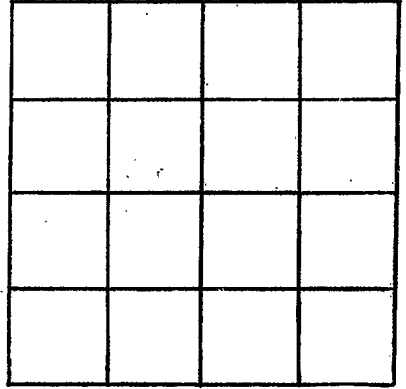

SECTION _____

Please indicate well location X.

ADDITIONAL INFORMATION

If more than one screen,
show locations of each on sketch.