

Marion
F 42
7-22-81

MISSISSIPPI
BOARD OF WATER COMMISSIONERS
416 North State Street
Jackson, Mississippi 39201

CODED

WATER WELL DRILLERS LOG

7-22-81 date well completed Hollinger firm name Marion county well located

LANDOWNER: Noyle Monte
Foxworth, MS
(mailing address)

description of formations encountered	from	to
Sand, gravel	0	60
CHALK	60	200
Sand	200	300
CHALK	300	320
COARSE SAND, gravel	320	350

WELL LOCATION:
sec. 33 T. 4 N. 13 R. 17E
S
4 miles NW of Foxworth
(distance) (direction) (nearest town)

WELL PURPOSE: POND FISH
(home, irrigation, municipal, industrial)

DEPT. OF NATURAL RESOURCES
BUREAU OF LAND & WATER RESOURCES

- WELL COMPLETION DATA:
- (1) diameter (inches) 2"
 - (2) total depth (feet) 350
 - (3) static water level (feet) Flow below top of ground.
 - (4) casing PVC 350
(material) (depth)
(size) if telescope see back.
 - (5) screen 20 330
(length) (depth to top)
2 PVC
(size) (material)
 - (6) pump NONE 35 min.
(HP) (yield gpm)
NONE
(type power)
 - (7) electric log _____
(yes or no)
(organization running log)
 - (8) how well bottom plugged SAND
CHALK


CODED
AUG
RECEIVED

DRILLERS REMARKS: Very good

RECEIVED
AUG 1 1981
1 2 3 4 5 6 7 8 9 10 11 12 13 14 15 16 17 18 19 20 21

If well telescopes please sketch and show depths.

GROUND LEVEL

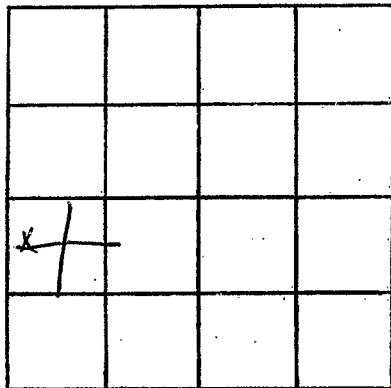

SECTION 33

Please indicate well location X.

ADDITIONAL INFORMATION

If more than one screen, show locations of each on sketch.