

Marion
F 43
5/15/81

MISSISSIPPI
BOARD OF WATER COMMISSIONERS
416 North State Street
Jackson, Mississippi 39201

CODED

WATER WELL DRILLERS LOG

5-15 1981 Hollinger Marion
date well completed firm name county well located

LANDOWNER: Marvin Price
Rt. 4
Columbia, MS
(mailing address)

description of formations encountered	from	to
CHALK, S, gravel	0	120
coarse sand	120	160

WELL LOCATION:
sec. 36 T. 4 N. R. 19 E.
1/2 miles W of Columbia
(distance) (direction) (nearest town)

WELL PURPOSE: Cramp
(home, irrigation, municipal, industrial)

- WELL COMPLETION DATA:
- (1) diameter (inches) 2"
 - (2) total depth (feet) 160
 - (3) static water level (feet) Flow below above top of ground.
 - (4) casing 2 150
(material) (depth)
If telescope see back.
(size)
 - (5) screen 10 150
(length) (depth to top)
2 PVC
(size) (material)
 - (6) pump None 20
(HP) (yield gpm)
None
(type power)
 - (7) electric log (yes or no)
 - (organization running log)
 - (8) how well bottom plugged stand
stark

DRILLERS REMARKS: Very good

DEPT. OF NATURAL RESOURCES
BUREAU OF LAND & WATER RESOURCES


AUG 26 1981

RECEIVED



If well telescopes please sketch and show depths.

GROUND LEVEL

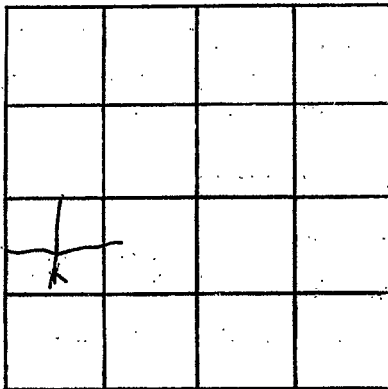

SECTION 36

Please indicate well location X.

ADDITIONAL INFORMATION

If more than one screen, show locations of each on sketch.