

Marion
F 44
9-20-81

MISSISSIPPI
BOARD OF WATER COMMISSIONERS
416 North State Street
Jackson, Mississippi 39201

CODED

WATER WELL DRILLERS LOG

9/20
date well completed

19 81

Tom Beatty Waterwell
firm name

Marion
county well located

LANDOWNER:
Tomlinson Interest, Inc.
Willoughby # 2
(mailing address)

description of formations encountered	from	to
Topsoil	0	1
Sand	1	2
GRAVEL	2	135

WELL LOCATION:
sec. 5 T 4 N R 19 E
S W
2 miles West of Goss
(distance) (direction) (nearest town)

WELL PURPOSE: art well line
(home, irrigation, municipal, industrial)

- WELL COMPLETION DATA:
- (1) diameter (inches) 4"
 - (2) total depth (feet) 135'
 - (3) static water level (feet) 10' ^{below} above top of ground.
 - (4) casing Steel, 135'
(material) (depth)
4"
(size) If telescope see back.
 - (5) screen 40 slot, 95'
(length) (depth to top)
4", Steel
(size) (material)
 - (6) pump 1/2 75
(HP) (yield gpm)
 - (type power)
 - (7) electric log
(yes or no)
 - (organization running log)
 - (8) how well bottom plugged point

CODED

DEPT. OF NATURAL RESOURCES
BUREAU OF LAND & WATER RESOURCES


OCT 20 1981

RECEIVED

DRILLERS REMARKS:

If well telescopes please sketch and show depths.

GROUND LEVEL

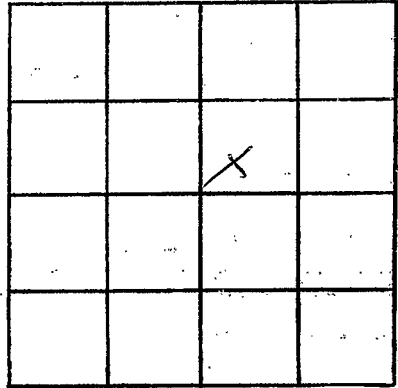

SECTION 3

Please indicate well location X.

ADDITIONAL INFORMATION

If more than one screen,
show locations of each on sketch.