

MISSISSIPPI DEPARTMENT OF NATURAL RESOURCES
 Bureau of Land and Water Resources
 Southport Mall
 P.O. Box 10631
 Jackson, Mississippi 39209
WATER WELL DRILLERS LOG

CODED

Marion
F 45
10-19-81

10-19-81 date well completed Griner Drilling Service, INC. firm name Marion county well located

LANDOWNER:
Louisiana Land Exploration
P.O. Box 60350
New Orleans, La 70160
 (mailing address)

description of formations encountered	from	to
<u>sand, gravel</u>	<u>0</u>	<u>63</u>
<u>chalk</u>	<u>63</u>	<u>210</u>
<u>streaked</u>	<u>210</u>	<u>315</u>
<u>chalk</u>	<u>315</u>	<u>336</u>
<u>sand</u>	<u>336</u>	<u>441</u>
<u>chalk</u>	<u>441</u>	<u>588</u>

WELL LOCATION: 435°S + 527°W
 sec. 19 T 4 N R 13 E NE/400
No. 1 Moses - East Morgantown
Smith miles East of Friend (nearest town)

WELL PURPOSE:
 (home, irrigation, municipal, industrial)

WELL COMPLETION DATA:

- (1) diameter (inches) 4"
- (2) total depth (feet) 588
- (3) static water level (feet) 80 ^(below) _(above) top of ground.
- (4) casing Steel, 58 441'
 (material) (depth)
4"
 (size) if telescope see back.
- (5) screen 42', 399'
 (length) (depth to top)
4", perforated
 (size) (material)
- (6) pump 7 75
 (HP) (yield gpm)
AC
 (type power)
- (7) electric log —
 (yes or no)
—
 (organization running log)
- (8) how well bottom plugged Orange
peel

CODED

DEPT. OF NATURAL RESOURCES
 BUREAU OF LAND & WATER RESOURCES


OCT 20 1981

RECEIVED

DRILLERS REMARKS:

If well telescopes please sketch and show depths.

GROUND LEVEL

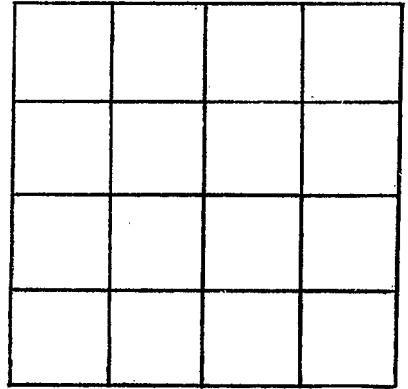

SECTION _____

Please indicate well location X.

ADDITIONAL INFORMATION

If more than one screen,
show locations of each on sketch.