

MISSISSIPPI DEPARTMENT OF NATURAL RESOURCES

Bureau of Land and Water Resources

Southport Mall

P.O. Box 10631

Jackson, Mississippi 39209

CODED

WATER WELL DRILLERS LOG

Griner Drilling Service, Inc.

Marion

MARION
F46
11/20/81

11-20-81 date well completed


Griner Drilling Service, Inc. firm name

Marion county well located

LANDOWNER:	description of formations encountered	from	to
<i>Natomus of North America</i>	<i>sand</i>	<i>0</i>	<i>105</i>
<i>155 Dairy Ashford</i>			
<i>Spire 100</i>	<i>chalk</i>	<i>105</i>	<i>294</i>
<i>Houston, MS 37079</i>			
WELL LOCATION: <i>500N+700'E</i>	<i>sand & chalk</i>	<i>294</i>	<i>693</i>
sec. <i>7</i> T. <i>4</i> (N) R. <i>13</i> (E) <i>Switzer</i>			
<i>Newsum</i> <i>Morgantown</i>	<i>chalk</i>	<i>693</i>	<i>777</i>
<i>Newsum, Field</i>			
WELL PURPOSE: <i>oil field supply</i>	<i>sand</i>	<i>777</i>	<i>840</i>
<i>oil field supply</i>			
WELL COMPLETION DATA:			
(1) diameter (inches) <i>3"</i>	CODED		
(2) total depth (feet) <i>840'</i>			
(3) static water level (feet) <i>125'</i> <small>(below above top of ground.)</small>			
(4) casing <i>steel</i> <i>399'</i>			
<small>(material) (depth)</small>			
<i>3"</i> <small>(size) if telescope see back.</small>			
(5) screen <i>42'</i> <i>359'</i>			
<small>(length) (depth to top)</small>			
<i>3"</i> <i>perforated</i>			
<small>(size) (material)</small>			
(6) pump <i>—</i> <i>75</i>			
<small>(HP) (yield gpm)</small>			
<i>AC</i>			
<small>(type power)</small>			
(7) electric log <i>—</i>			
<small>(yes or no)</small>			
<small>(organization running log)</small>			
(8) how well bottom plugged <i>orange</i>			
<i>peel</i>			
DRILLERS REMARKS:	DEPT. OF NATURAL RESOURCES BUREAU OF LAND & WATER RESOURCES		
	JAN 15 1982		
	RECEIVED		

If well telescopes please sketch and show depths.

GROUND LEVEL

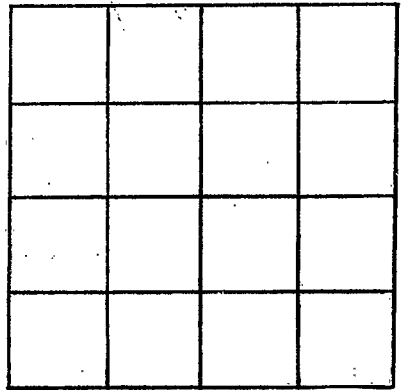

SECTION _____

Please indicate well location X.

ADDITIONAL INFORMATION

If more than one screen, show locations of each on sketch.