

MISSISSIPPI DEPARTMENT OF NATURAL RESOURCES

Bureau of Land and Water Resources

Southport Mall

P.O. Box 10631

Jackson, Mississippi 39209

WATER WELL DRILLERS LOG

CODED

Griner Drilling Service, Inc.

Marion

MARION
F47
2/2/82

2-2-82 date well completed

Griner Drilling Service, Inc. firm name

Marion county well located

LANDOWNER:

SUN Exploration & Production
P.O. Box 3308
Lafayette, MS 70502
(mailing address)

description of formations encountered

from

to

clay	0	57
sand & gravel	57	148
clay	148	160
sand, gravel	160	232
clay	232	252

WELL LOCATION: 450' S + 600' W

sec. 17, T. 40S R. 130E of
Morgan Unit Morgantown
(distance) (direction) (nearest town)

WELL PURPOSE: oil field supply
(home, irrigation, municipal, industrial)

WELL COMPLETION DATA:

- (1) diameter (inches) 4"
- (2) total depth (feet) 252'
- (3) static water level (feet) 20' below top of ground.
- (4) casing Steel, 231' (material) (depth)
4" (size) if telescope see back.
- (5) screen 42', 189' (length) (depth to top)
4" perforated (size) (material)
- (6) pump — 75 (HP) (yield gpm)
AC (type power)
- (7) electric log (yes or no)
- (organization running log)

CODED

(8) how well bottom plugged orange
peel

DRILLERS REMARKS:


DEPT. OF NATURAL RESOURCES
BUREAU OF LAND & WATER RESOURCES

FEB 16 1982

RECEIVED

If well telescopes please
sketch and show depths.

GROUND LEVEL

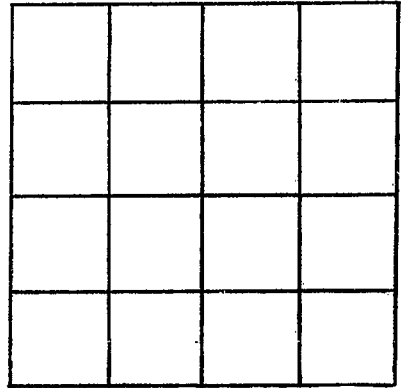

SECTION _____

Please indicate well location X.

ADDITIONAL INFORMATION

If more than one screen,
show locations of each on sketch.