

MARION  
F48  
8-10-82

MISSISSIPPI DEPARTMENT OF NATURAL RESOURCES  
Bureau of Land and Water Resources  
Southport Mall  
P.O. Box 10631

Jackson, Mississippi 39209

WATER WELL DRILLERS LOG

Griner Drilling Service, Inc.

Marion

8-10-82 date well completed

Griner Drilling Service, Inc. firm name

Marion county well located

LANDOWNER:

Tomlinson Interest, Inc.  
2201 Hardy Street  
Hattiesburg, Ms. 39401  
(mailing address)

description of formations encountered

from

to

streaked chalk and sand 0 42

WELL LOCATION:

188' S + 2000' E of  
sec. 16 T 4 R 13 W N 100' of  
East Morganbun Field  
(distance) (direction) (nearest town)

sand, gravel 42 147

streaked 147 189

WELL PURPOSE: oilfield supply  
(home, irrigation, municipal, industrial)

WELL COMPLETION DATA:

- (1) diameter (inches) 4"
- (2) total depth (feet) 189'
- (3) static water level (feet) 5' below top of ground.
- (4) casing steel, 147' (material) (depth)  
4" (size) If telescope see back.
- (5) screen 42', 105' (length) (depth to top)  
4" perforated (size) (material)
- (6) pump — 100 (HP) (yield gpm)  
AC (type power)
- (7) electric log — (yes or no)  
(organization running log)

(8) how well bottom plugged orange peel

DRILLERS REMARKS:


DEPT. OF NATURAL RESOURCES  
BUREAU OF LAND & WATER RESOURCES

AUG 12 1982

RECEIVED

If well telescopes please sketch and show depths.

GROUND LEVEL

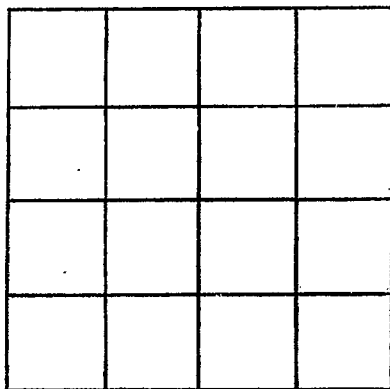

SECTION \_\_\_\_\_

Please indicate well location X.

ADDITIONAL INFORMATION

If more than one screen, show locations of each on sketch.