

MISSISSIPPI DEPARTMENT OF NATURAL RESOURCES

Bureau of Land and Water Resources

Southport Mall

P.O. Box 10631

Jackson, Mississippi 39209

CODED

WATER WELL DRILLERS LOG

*Griner Drilling Service, Inc.*

*Marion*

*MARION*  
*F 49*  
*5/12/83*

date well completed

firm name

county well located

LANDOWNER:

*Florida Exploration Co.*  
*Box Number 27711*  
*Houston, Texas 77227*

(mailing address)

description of formations encountered

from

to

*clay, gravel*

*0*

*21*

*chalk*

*21*

*84*

WELL LOCATION: *300'S + 240'S E*

sec. *9* T. *4* N. R. *19* E. NW/4

*sand, gravel*

*84*

*147*

*chalk*

*147*

*168*

*Robertson East Mountain*

(distance) (nearest town)

WELL PURPOSE: *oilfield supply*

(home, irrigation, municipal, industrial)

WELL COMPLETION DATA:

(1) diameter (inches) *4"*

(2) total depth (feet) *168'*

(3) static water level (feet) *10'* *below* top of ground.

CODED

(4) casing *Steel*, *147'* (material), (depth)

*4"* (size) if telescope see back.

(5) screen *42'*, *105'* (length), (depth to top)

*4"* *perforated* (size), (material)

(6) pump *90* (HP), (yield gpm)

*AC* (type power)

(7) electric log (yes or no)

(organization running log)

(8) how well bottom plugged *orange*

*peel*

DEPT. OF NATURAL RESOURCES  
BUREAU OF LAND & WATER RESOURCES


MAY 20 1983

DRILLERS REMARKS:

RECEIVED

If well telescopes please  
sketch and show depths.

GROUND LEVEL

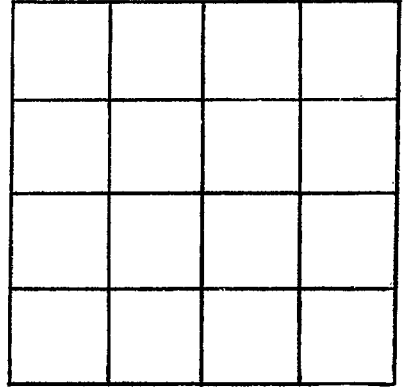

SECTION \_\_\_\_\_

Please indicate well location X.

ADDITIONAL INFORMATION

If more than one screen,  
show locations of each on sketch.