

MISSISSIPPI DEPARTMENT OF NATURAL RESOURCES

Bureau of Land and Water Resources

Southport Mall

P.O. Box 10631

Jackson, Mississippi 39209

WATER WELL DRILLERS LOG

MARION
F51

Coded

11-12 1987
date well completed

HOLLINGER
firm name

MARION
county well located


LANDOWNER:	description of formations encountered	from	to
<u>Neville Ryals</u>			
<u>Rt. 1 Morgantown, MS</u> (mailing address)	<u>SAND, CLAY, GRAVEL</u> <u>CHALK</u> <u>Sand</u>	<u>0</u> <u>330</u> <u>100</u>	<u>330</u> <u>770</u> <u>770</u>
WELL LOCATION:			
sec. <u>9</u> T. <u>4</u> (N) S. R. <u>20</u> (E) (W) 19 <u>2</u> miles <u>N</u> of <u>MORGANTOWN</u> (distance) (direction) (nearest town)			
WELL PURPOSE: <u>Pond</u> (home, irrigation, municipal, industrial)			
WELL COMPLETION DATA:			
(1) diameter (inches) <u>2"</u>			
(2) total depth (feet) <u>770</u>			
(3) static water level (feet) <u>Flow</u> below top of ground.			
(4) casing <u>PVC</u> <u>720</u> (material) (depth)			
(size) if telescope see back.			
(5) screen <u>50</u> <u>720</u> (length) (depth to top)			
<u>2</u> <u>PVC</u> (size) (material)			
(6) pump <u>NONE</u> <u>10</u> (HP) (yield gpm)			
<u>NONE</u> (type power)			
(7) electric log _____ (yes or no)			
(organization running log)			
(8) how well bottom plugged _____			
DRILLERS REMARKS: <u>Good Flow</u>			

RECEIVED
DEC 11 1987

Department of Natural Resources
Bureau of Land & Water Resources

If well telescopes please sketch and show depths.

GROUND LEVEL

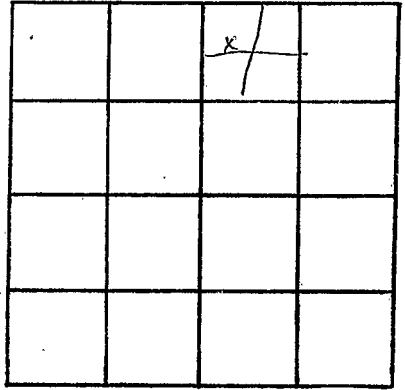

SECTION 9

Please indicate well location X.

ADDITIONAL INFORMATION

A series of horizontal lines for writing additional information, starting below the 'ADDITIONAL INFORMATION' header and extending to the bottom of the page.

If more than one screen, show locations of each on sketch.