

MISSISSIPPI DEPARTMENT OF NATURAL RESOURCES

Bureau of Land and Water Resources

Southport Mall

P.O. Box 10631

Jackson, Mississippi 39209

WATER WELL DRILLERS LOG

Marion  
F 52  
11-17-87

Colored

11-17-87 Griner Drilling Service, Inc.


Marion

date well completed

firm name

county well located

LANDOWNER:	description of formations encountered	from	to
<u>Chesley Pruet Drilling</u> <u>P.O. Box 324</u> <u>Laurel, Ms. 39440</u> (mailing address)	<u>Sand, pea gravel</u>	<u>0</u>	<u>21</u>
	<u>chalk, streaked</u>	<u>21</u>	<u>105</u>
WELL LOCATION: <u>1142' N 1500' W</u> sec. <u>33</u> T. <u>40</u> N. R. <u>13</u> E. of <u>SE/100'</u>	<u>SAND, PEA GRAVEL</u>	<u>105</u>	<u>210</u>
<u>No. 1 in 5 Morgan town</u> <u>crossroads</u> (distance) <u>1/2 mile</u> (nearest town)			
WELL PURPOSE: <u>oilfield rig</u> (home, irrigation, municipal, industrial)			
WELL COMPLETION DATA:			
(1) diameter (inches) <u>4"</u>			
(2) total depth (feet) <u>210'</u>			
(3) static water level (feet) <u>10'</u> below top of ground.			
(4) casing <u>steel 210'</u> (material) (depth)			
<u>4"</u> (size) if telescope see back.			
(5) screen <u>42'</u> <u>168'</u> (length) (depth to top)			
<u>4"</u> <u>perforated</u> (size) (material)			
(6) pump <u>—</u> <u>90</u> (HP) (yield gpm)			
<u>AC</u> (type power)			
(7) electric log (yes or no) <u>no</u>			
(organization running log)			
(8) how well bottom plugged <u>orange</u> <u>peel</u>			
DRILLERS REMARKS:			

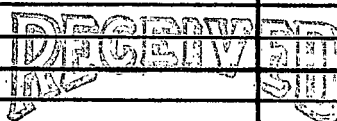


JAN 4 1988

Department of Natural Resources  
 Bureau of Land & Water Resources

If well telescopes please  
sketch and show depths.

GROUND LEVEL

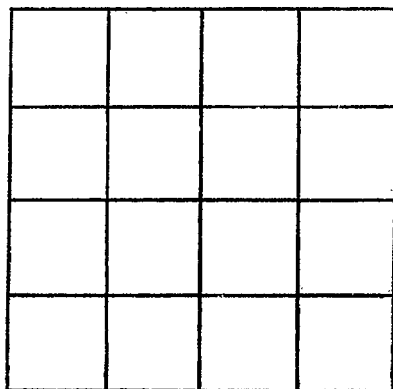

SECTION \_\_\_\_\_

Please indicate well location X.

ADDITIONAL INFORMATION

If more than one screen,  
show locations of each on sketch.