

MISSISSIPPI DEPARTMENT OF ENVIRONMENTAL QUALITY

Office of Land and Water Resources

P. O. Box 10631

Jackson, MS 39289-0631

WATER WELL DRILLERS LOG

COUNTY WELL LOCATED
Marion

WELL NUMBER
F-103

CODED

PERMIT NUMBER

NAME OF DRILLING FIRM
Thompson Bros

DATE WELL COMPLETED
4-22-03

NAME & MAILING ADDRESS OF LANDOWNER
E.O.G Resources

821 ESE loop 323 suite 408
Tyler, Texas 75701

Latitude:
Longitude:

WELL LOCATION. SEC TOWNSHIP RANGE
20 4 (N) 13 (E) W

DISTANCE DIRECTION NEAREST TOWN
7 Miles NW of Columbia

OTHER LANDMARK

WELL PURPOSE: Home, Irrigation, Municipal, Industrial, Fish Pond, etc.
Rig supply

PUMP DATA

PUMP TYPE (Circle One):
Submersible, Turbine, Jet, Flowing Well,
Other (Describe)

POWER TYPE (Circle One):
Electric, Tractor, Diesel, Gasoline, Butane,
Other (Describe) H/P

DESCRIPTION OF FORMATIONS ENCOUNTERED	FROM	TO
<i>sand</i>	<i>0</i>	<i>20</i>
<i>big gravel</i>	<i>20</i>	<i>23</i>
<i>sand & pea gravel</i>	<i>25</i>	<i>160</i>

WELL DATA

Well Depth Casing Diameter (In.) Casing Length (Ft.)
160 4 140

Type of Casing Hole Depth Depth to Static Water Level
PVC 160 5'

TYPE OF COMPLETION: (Circle One or More):
 Gravel Packed, Underreamed, Telescoped,
 Natural Development, Open Hole, Other
(Describe)

WELL GROUTED TO A DEPTH OF 10 FEET
Type Grout (circle one): Cement, Bentonite, or Mix

SCREEN DATA

Diameter - Inches Length - Feet Slot Size - Inches
4 20 .020

Screen Type Depth to Bottom - Feet
PVC slot 160

RECEIVED
APR 30 2003
BY: *[Signature]*

Top of Lap Pipe or Reducer in Casing
FEET IF TELESCOPED OR MORE THAN ONE SCREEN: USE BACK PAGE


I certify that the well was drilled, constructed and completed in accordance with all applicable Requirements of the Mississippi Department of Environmental Quality and/or the Mississippi Department of Health regulations and state laws.

John Thompson 0-0679
Signature of Licensed Driller and License No.

4-28-03
Date

If well telescopes please sketch and show depths.

GROUND LEVEL

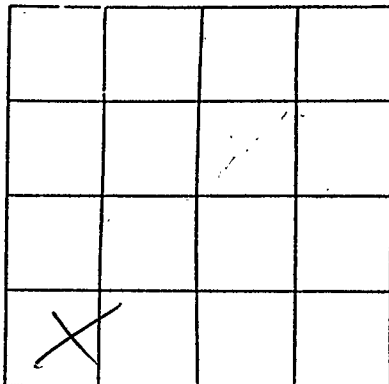

SECTION _____

Please indicate well location X.

Pump Capacity (GPM)	No. of Stages	Setting Depth	FT.
---------------------	---------------	---------------	-----

PUMP TEST

Well yielded 100 GPM with
 a drawdown of 15 ft.
 after airlift hours of pumping

LOG DATA

TYPE OF LOG RUN (Circle One):
 Electric, Gamma Ray, Density, Sonic, No Log Run., Neutron,
 Other (Describe) _____

Name of Organization Running Log

GEOLOGIC DATA (Office Use Only)

Surface Elev.	Geologic Unit	Unit Thickness	Depth to Top
Subs. SWL	Date	Analysis	Aquifer Test

Driller's Remarks

If more than one screen,
 show location of each on sketch.